



Public Works Department

390 Towne Centre Dr. – Lathrop, CA 95330

Phone (209) 941-7430

www.ci.lathrop.ca.us

ADDENDUM NO. 2 – January 9, 2025

**Valverde Park Renovation – CIP PK 24-04
Mossdale Park Renovation – CIP PK 25-01**

This addendum amends the Contract Drawings and Specifications for this project as follows:

- 1. See CIP PK 24-04 / 25-01 REVISED SHEETS L6.0, L6.1, L12.1, L12.2, L14.2**
Attachment A. These sheets replace previous corresponding sheets.

The following Request for Information (RFI) have been received by the City, and are followed by the City's answer (A):

RFI 1: The specification/plan state that the infield mix will be provided by the City and the contractor is responsible for transporting the material to the project site. Please confirm the exact location of the City yard or storage facility where the infield mix will be available for pickup.

A1: City's infield mix stockpile is located behind Lathrop High School on Dos Reis Road. It's a dirt road. The City will give access to Contractor.

RFI 2: Refer to L6.1, The note schedule "I-08" states the replacement of valve B27 with a new drip zone control kit. The contractor needs to reconnect control wires from the existing valve B27, but it is not shown on plans. Please confirm if the existing valve is at the same location of the proposed valve. If not, please provide its location for reconnection of wires.

A2: New Drip Zone Control Kit (B27) will replace existing valve B27 in the same location.

RFI 3: Please provide an existing irrigation as-built plan for any repairs during construction.

A3: Irrigation As-Builts will be made available to the Contractor AFTER award.

RFI 4: Please provide the location of the existing controller for running new control wires of proposed valves. Also, please advise if it is a conventional or 2-wire system one.

A4: Improvements propose use of existing irrigation stations/conventional controller wires at or near the location of proposed valves. Record drawings with the locations of controllers and other components will be provided to the contractor after award. Existing irrigation systems are conventional wiring.

RFI 5: Refer to L12.1, there is a new control zone kit called-out "I-20" which is not mentioned in the note schedule at the same sheet. Please clarify the description of that call-out.

A5: Note I-20 has been added noting "LOCATE UNUSED (TEMPORARY) VALVE A8 IN THIS APPROXIMATE LOCATION, REMOVE VALVE AND REPLACE WITH NEW ZONE CONTROL KIT. CONNECT TO CONTROLLER USING EXISTING ZONE A8 CONTROL WIRES. CONNECT NEW VALVE TO PROPOSE TREE DRIP RING ZONE AS SHOWN ON PLANS. REPLACE REPAIR TURF AND IRRIGATION COMPONENTS DAMAGED DURING CONSTRUCTON OPERATIONS."

RFI 6: Bid item #29A show 82 EA of 5-gallon shrubs. Actually, there are just 35 EA shown on planting plans per doing take-off. Please clarify.

A6: Provide pricing based on the quantities listed in the bid form.

RFI 7: Irrigation detail 5/L4.12 indicates dripline shall be no more than 6" deep. However, detail 12/L14.12 shows that dripline shall be installed above grade. Please clarify.

A7: Dripline for project with the exception of tree drip rings, shall be buried 4"-6" deep. Tree drip rings shall be installed on surface.

RFI 8: The irrigation plan sheet L12.1 indicates a new drip remote control valve to be installed on the existing mainline. Please confirm whether the control wire of this valve shall be reconnected from the replaced existing valve located there. If not, please kindly provide the location of the existing controller for coordination purposes.

A8: New Drip Zone Control Kit at Valverde will replace an existing (temporary) irrigation valve (A8) anticipated to be located within 50ft of the proposed new valve location. Contractor shall assume extension/trenching of up to 50 LF of conventional control wire between existing valve and new valve locations.

The following additional changes have been incorporated into the attached revised plan sheets:

SHEET L6.0– MOSSDALE LANDING PARK – IRRIGATION PLAN (IRRIGATION LEGEND): Description of Remote Control Valve changed to “REMOTE CONTROL VALVE: RAIN BIRD PESB-R INDUSTRIAL REMOTE CONTROL VALVE, GLOBE CONFIGURATION WITH SCRUBBER TECHNOLOGY, SIZE PER PLANS.”

SHEET L6.0– MOSSDALE LANDING PARK – IRRIGATION PLAN (IRRIGATION LEGEND): Symbol for Drip Remote Control Zone Kit updated and description changed to “DRIP REMOTE ZONE CONTROL KIT: RAINBIRD XCZ-150-LCDR”

SHEET L6.1– MOSSDALE LANDING PARK – IRRIGATION PLAN (IRRIGATION LEGEND): Description of Remote Control Valve changed to “REMOTE CONTROL VALVE: RAIN BIRD PESB-R INDUSTRIAL REMOTE CONTROL VALVE, GLOBE CONFIGURATION WITH SCRUBBER TECHNOLOGY, SIZE PER PLANS.”

SHEET L6.1– MOSSDALE LANDING PARK – IRRIGATION PLAN (IRRIGATION LEGEND): Symbol for Drip Remote Control Zone Kit updated and description changed to “DRIP REMOTE ZONE CONTROL KIT: RAINBIRD XCZ-150-LCDR”

SHEET L6.1– MOSSDALE LANDING PARK – IRRIGATION PLAN: Updated Valve type symbols.

SHEET L6.1– MOSSDALE LANDING PARK – IRRIGATION PLAN: Change Proposed Valve B19 size to 1.5”

SHEET L6.1– MOSSDALE LANDING PARK – IRRIGATION PLAN: Change Proposed Valve B18 size to 1”

SHEET L6.1– MOSSDALE LANDING PARK – IRRIGATION PLAN: Change Proposed Valve B28 size to 1.5”

SHEET L12.0– VALVERDE PARK – IRRIGATION PLAN (IRRIGATION LEGEND): Updated symbol for Drip Remote Control Zone Kit.

SHEET L12.1– VALVERDE PARK – IRRIGATION PLAN (IRRIGATION LEGEND): Updated symbol for Drip Remote Control Zone Kit.

SHEET L12.1– VALVERDE PARK – IRRIGATION PLAN: Updated proposed (Drip Control Zone Kit) valve symbol.

Except as modified by this Addendum, all other terms and conditions of the Contract Documents remain unchanged and in full force and effect.

When submitting the bid for the project, the Contractor must acknowledge receipt of the addendum.

Recommended by:



Leisser P. Mazariegos
Project Manager

1/9/2026
Date




12150 Tributary Point Drive, Suite 140
Gold River, CA 95670
916.985.4366
www.calanderassociates.com

REVISION DATE
ADDENDUM 2 01/09/2026




MOSSDALE LANDING AND VALVERDE PARK RENOVATION

LATHROP, CA

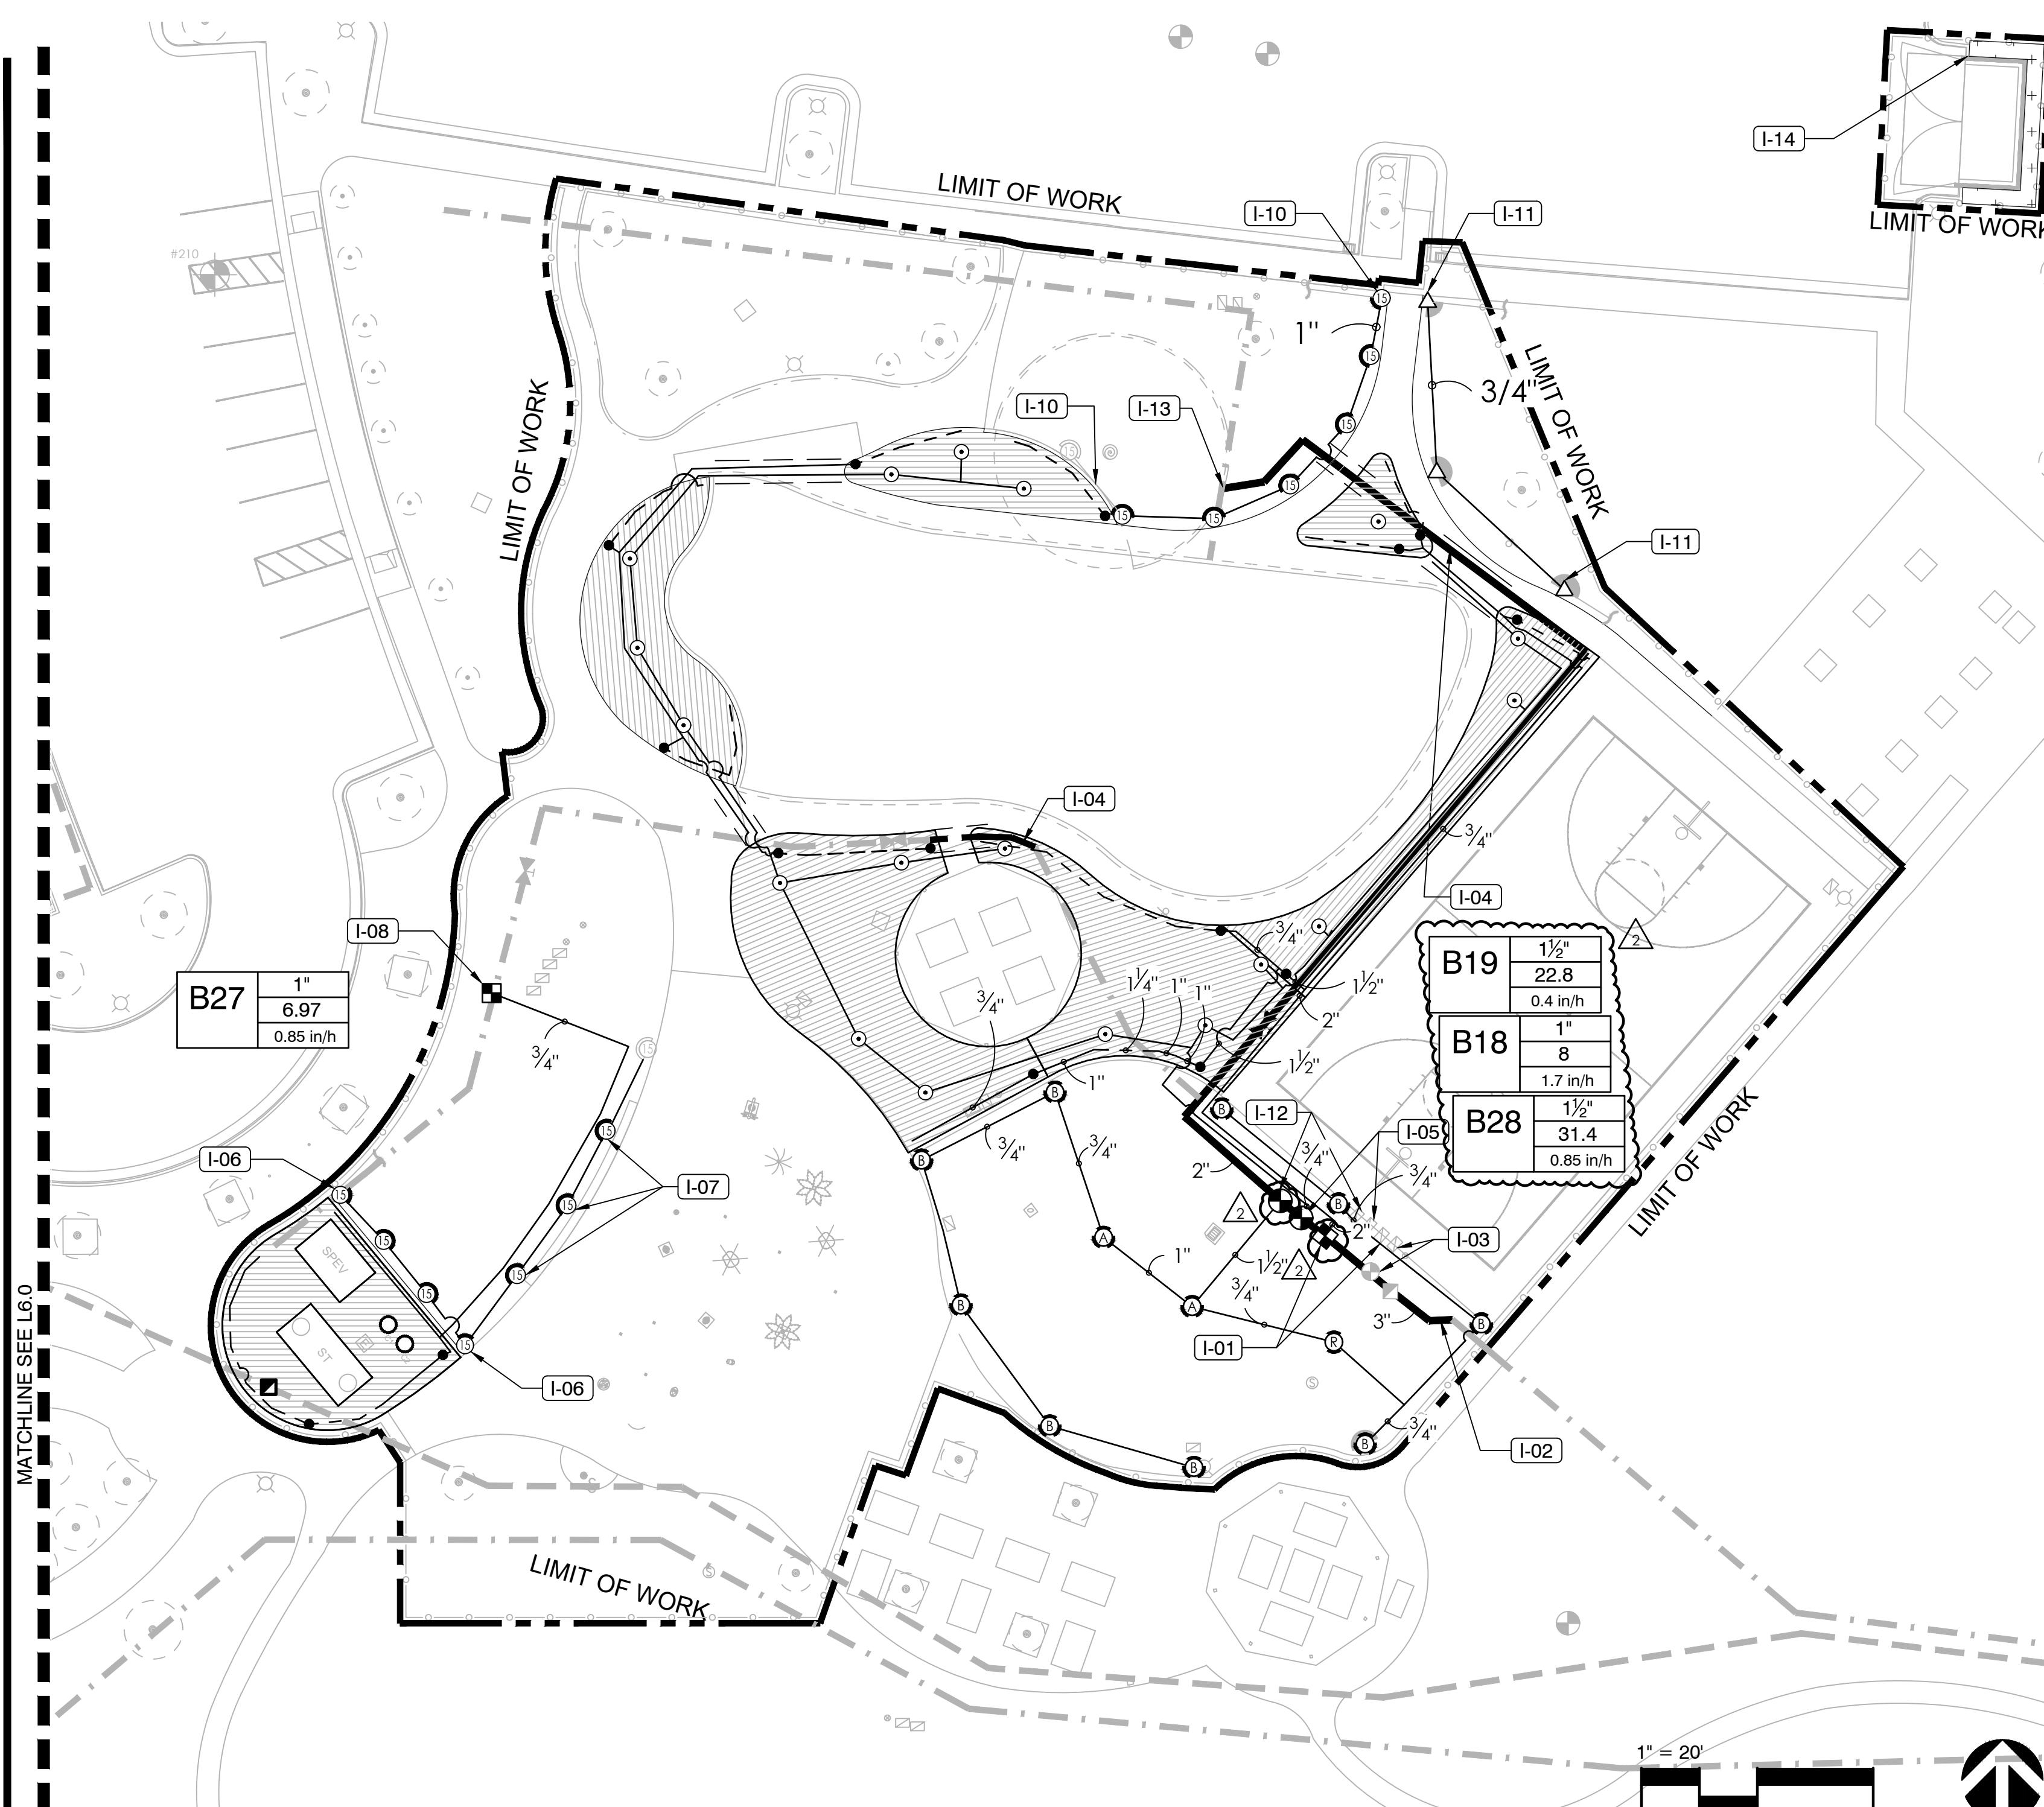

SEE SHEET L6.0 FOR IRRIGATION NOTES

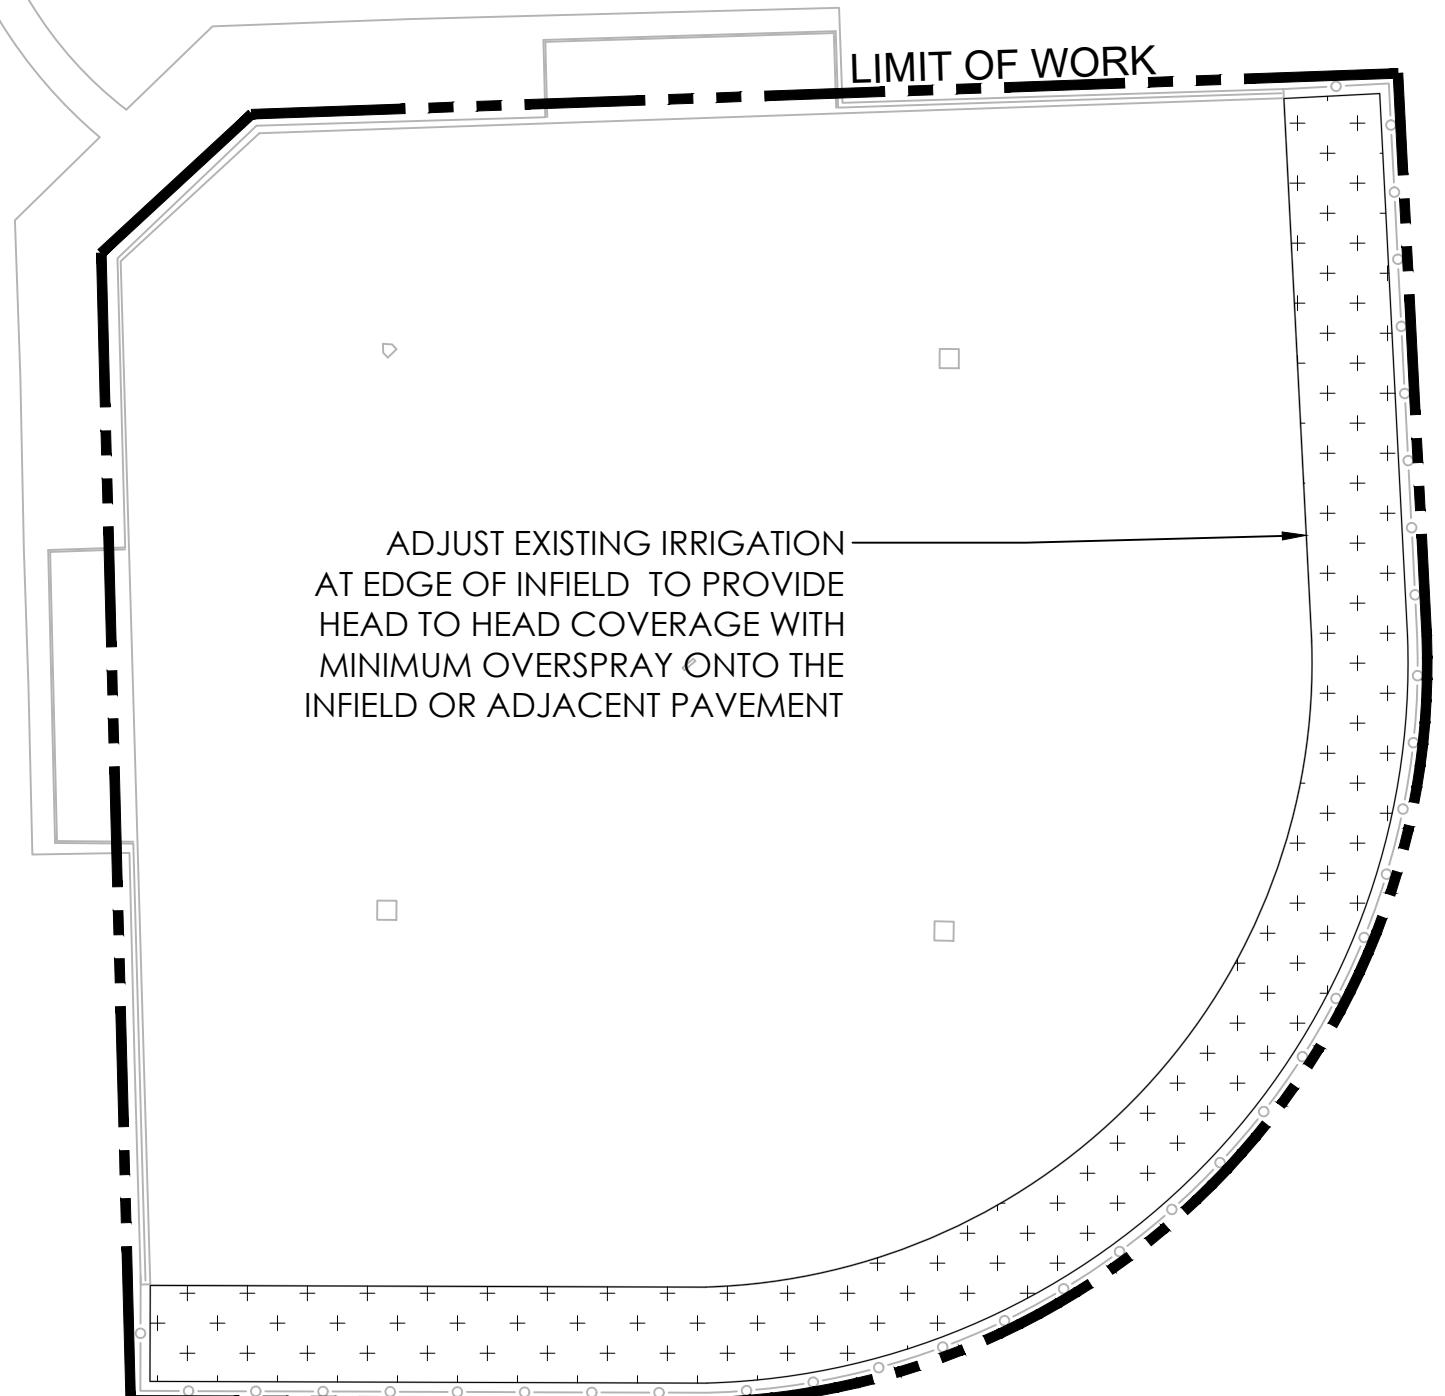


IRRIGATION LEGEND

- AREA TO RECEIVE DRIP DRIPLINE: TORO DL2000 SERIES SUBSURFACE DRIPLINE TORO DL2000 SUBSURFACE DRIPLINE, 0.5 GPH EMMITERS AT 18" O.C. WITH LINES SPACED 18" APART. OFFSET EMMITTERS FOR TRIANGULAR SPACING PATTERN. 5 L14.2
- TREE BUBBLER: RAINBIRD RWS-B-1402: 0.5 GPM BUBBLER ON RISER, 12" VERSATILE SWING ASSEMBLY WITH 1/2" (15/21) M NPT INLET (2 PER TREE) 1 L6.0
- EXISTING REMOTE CONTROL VALVE
- REMOTE CONTROL VALVE: RAIN BIRD PESB-R INDUSTRIAL REMOTE CONTROL VALVE, GLOBE CONFIGURATION WITH SCRUBBER TECHNOLOGY, SIZE PER PLANS. 1 L14.2
- DRIP REMOTE CONTROL ZONE KIT: RAINBIRD XCZ-150-LCDR DRIP ZONE VALVE ASSEMBLY, PER CITY STDS. 2 L14.2
- TURF ROTARY: HUNTER MP 2000 PROS-06-PRS30-CV SHRUB ROTATOR, 6IN. POP-UP WITH FACTORY INSTALLED CHECK VALVE, PRESSURE REGULATED TO 30 PSI, MP ROTATOR NOZZLE ON PRS30 BODY. K=BLACK ADJ ARC 90-210, G=GREEN ADJ ARC 210-270, R=RED 360 ARC. 9 L14.2
- TURF ROTARY: HUNTER MP3000 PROS-06-PRS30-CV SHRUB ROTATOR, 6IN. POP-UP WITH FACTORY INSTALLED CHECK VALVE, PRESSURE REGULATED TO 30 PSI, MP ROTATOR NOZZLE ON PRS30 BODY. B=BLUE ADJ ARC 90-210, Y=YELLOW ADJ ARC 210-270, A=GRAY 360 ARC. 2 L14.2
- TURF ROTARY: RAIN BIRD 1804-PRS 15 SERIES MPR TURF SPRAY 4.0IN. POP-UP SPRINKLER WITH CO-MOLDED WIPER SEAL. 1/2IN. NPT FEMALE THREADED INLET. PRESSURE REGULATING. 3 L14.2
- RAIN BIRD 5004-PC-LA 1.5TURF ROTOR, 4.0IN. POP-UP, PLASTIC RISER. ADJUSTABLE TO FULL CIRCLE. LOW ANGLE NOZZLE. 4 L14.2
- EXISTING QUICK COUPLER VALVE
- QUICK COUPLING VALVE: RAINBIRD 33-DNP 4 L14.2
- EXISTING GATE VALVE
- GATE VALVE: NIBCO, CLASS 125, T-113, LINE SIZE, INSTALL IN VALVE BOX 3 L14.2
- FLUSH VALVE: TORO, T-FCH-H, INSTALL AT LOW END OF DRIP HEADER LINE 7 L14.2
- AIR RELEASE VALVE: TORO, T-YD-500-34, INSTALL AT HIGH END OF DRIP HEADER LINE 8 L14.1
- DRIP IRRIGATION INDICATOR: HUNTER, ECO-ID
- DRIP HEADER, SCH 40 PVC, SIZE PER PLAN
- LATERAL / HEADER CONNECTION
- LATERAL LINE, CLASS 200 PVC, SIZE PER PLAN 8 L14.1
- EXISTING LATERAL LINE
- EXISTING MAINLINE (POTABLE)
- EXISTING MAINLINE (NON-POTABLE)
- IRRIGATION MAINLINE: SCH 40 FOR MAINLINE 1 3/4" OR SMALLER, CLASS 315 PVC FOR 2"3" AND CLASS 200 BELL AND GASKET FOR MAINLINE LARGER THAN 3" 8 L14.1
- SLEEVE, SCH 40 PVC, SIZE AS REQUIRED
- VALVE CALLOUT
 - VALVE NUMBER
 - X # VALVE SIZE
 - X VALVE FLOW
 - X PRECIPITATION RATE
 - X WATER-USE

REFERENCE NOTES SCHEDULE

- I-01 REPLACE EXISTING VALVE (B17) WITH NEW ZONE CONTROL KIT AND CONNECT TO AREAS TO RECEIVE DRIP EMMITTERS. RECONNECT CONTROL WIRES FROM IRRIGATION CONTROLLER STATION (B17)
- I-02 ADJUST EXISTING IRRIGATION MAINLINE ALIGNMENT TO EDGE OF PROPOSED BASKETBALL COURT
- I-03 RELOCATE EXISTING REMOTE CONTROL VALVE (B16) AND QUICK COUPLING VALVE TO ADJUSTED MAINLINE ALIGNMENT
- I-04 ADJUST EXISTING IRRIGATION MAINLINE ALIGNMENT OUTSIDE FOOTPRINT OF PROPOSED PAVEMENT AND PLAY AREA.
- I-05 REPLACE EXISTING VALVE (B18) WITH NEW REMOTE CONTROL VALVE AND CONNECT TO NEW TREE BUBBLER ZONE. RECONNECT CONTROL WIRES FROM IRRIGATION CONTROLLER STATION (B18)
- I-06 RELOCATE QUARTER AND HALF TURF SPRAY HEADS TO EDGE OF NEW MOWBAND AND RECONNECT TO EXISTING ZONE (B26). CUT AND CAP ZONES (B26) AND (B25) SOUTH OF NEW MOWBAND.
- I-07 ADJUST LOCATION OF TURF SPRAY HEADS TO BACK OF NEW SEATWALL AND RECONNECT TO EXISTING ZONE (B26)
- I-08 REPLACE EXISTING UNUSED VALVE (B27) WITH NEW DRIP ZONE CONTROL KIT AND CONNECT TO DRIP AREA TO THE SOUTH. RECONNECT CONTROL WIRES FROM IRRIGATION CONTROLLER STATION (B27)
- I-10 ADJUST LOCATION OF TURF SPRAY HEADS TO EDGE OF WALK, PROVIDING HEAD TO HEAD COVERAGE WITH MINIMAL OVERSPRAY ONTO PAVEMENT AND RECONNECT LATERALS TO EXISTING ZONE (B21)
- I-11 ADJUST LOCATION OF TURF SPRAY HEADS TO EDGE OF WALK, PROVIDING HEAD TO HEAD COVERAGE WITH MINIMAL OVERSPRAY ONTO PAVEMENT AND RECONNECT LATERALS TO EXISTING ZONE (A9)
- I-12 REPLACE EXISTING VALVE (B19) WITH NEW REMOTE CONTROL VALVE AND CONNECT TO NEW TURF ROTARY SPRAY ZONE. RECONNECT CONTROL WIRES FROM IRRIGATION CONTROLLER STATION (B19)
- I-13 ALIGN AND CONNECT EXISTING MAINLINE TO PROPOSED MAINLINE
- I-14 ADJUST IRRIGATION AT NEW DUMPSTER TO RESTORE IRRIGATION TO REMAINING PLANT MATERIAL.

KEY MAP

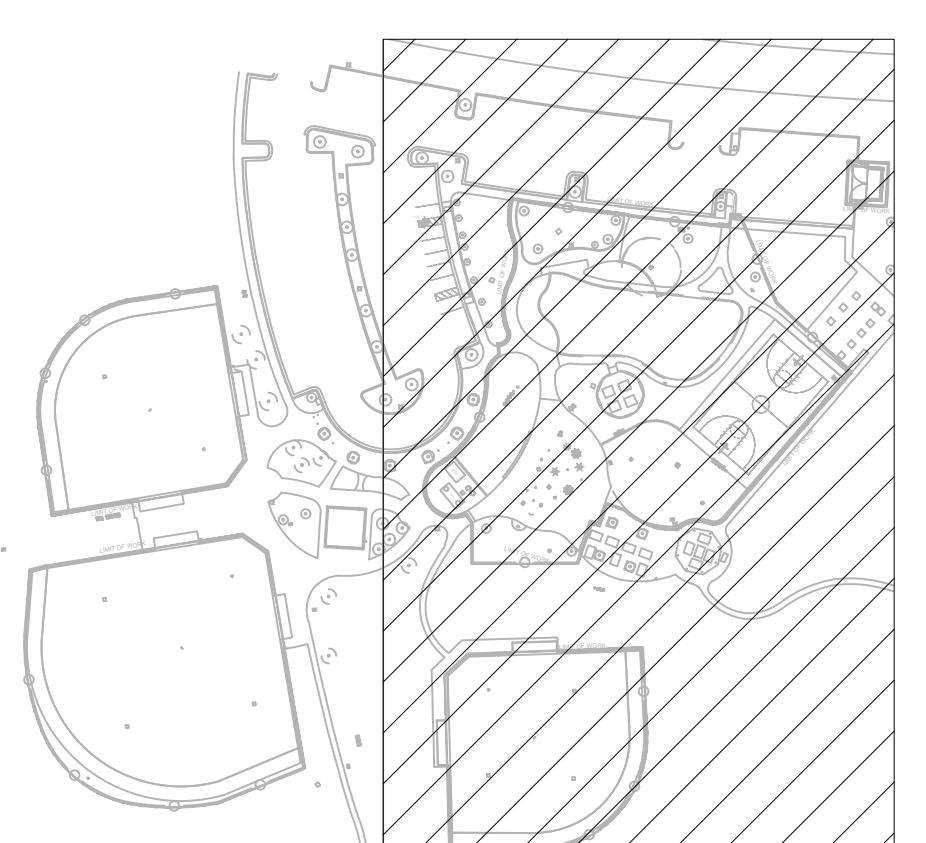

SUBMITTAL DATE
50% CDs 05/03/25
100% CDs 08/27/25
BID SET 11/14/25

PROJECT NO: 25003
DRAWN BY: RH
CHECKED BY: MR
SCALE: As Shown

SHEET TITLE
MOSSDALE LANDING
PARK -
IRRIGATION PLAN

SHEET
L6.1

11 OF 37



12150 Tributary Point Drive, Suite 140
Gold River, CA 95670
916.985.4366
www.calanderassociates.com

REVISION DATE
ADDENDUM 2 01/09/2026



MOSSDALE LANDING AND VALVERDE PARK RENOVATION

LATHROP, CA


SUBMITTAL DATE
50% CDs 05/03/25
100% CDs 08/27/25
BID SET 11/14/25

PROJECT NO: 25003
DRAWN BY: RH
CHECKED BY: MR
SCALE: As Shown
SHEET TITLE: VALVERDE PARK -
IRRIGATION PLAN

SHEET
L12.0

22 OF 37

IRRIGATION LEGEND



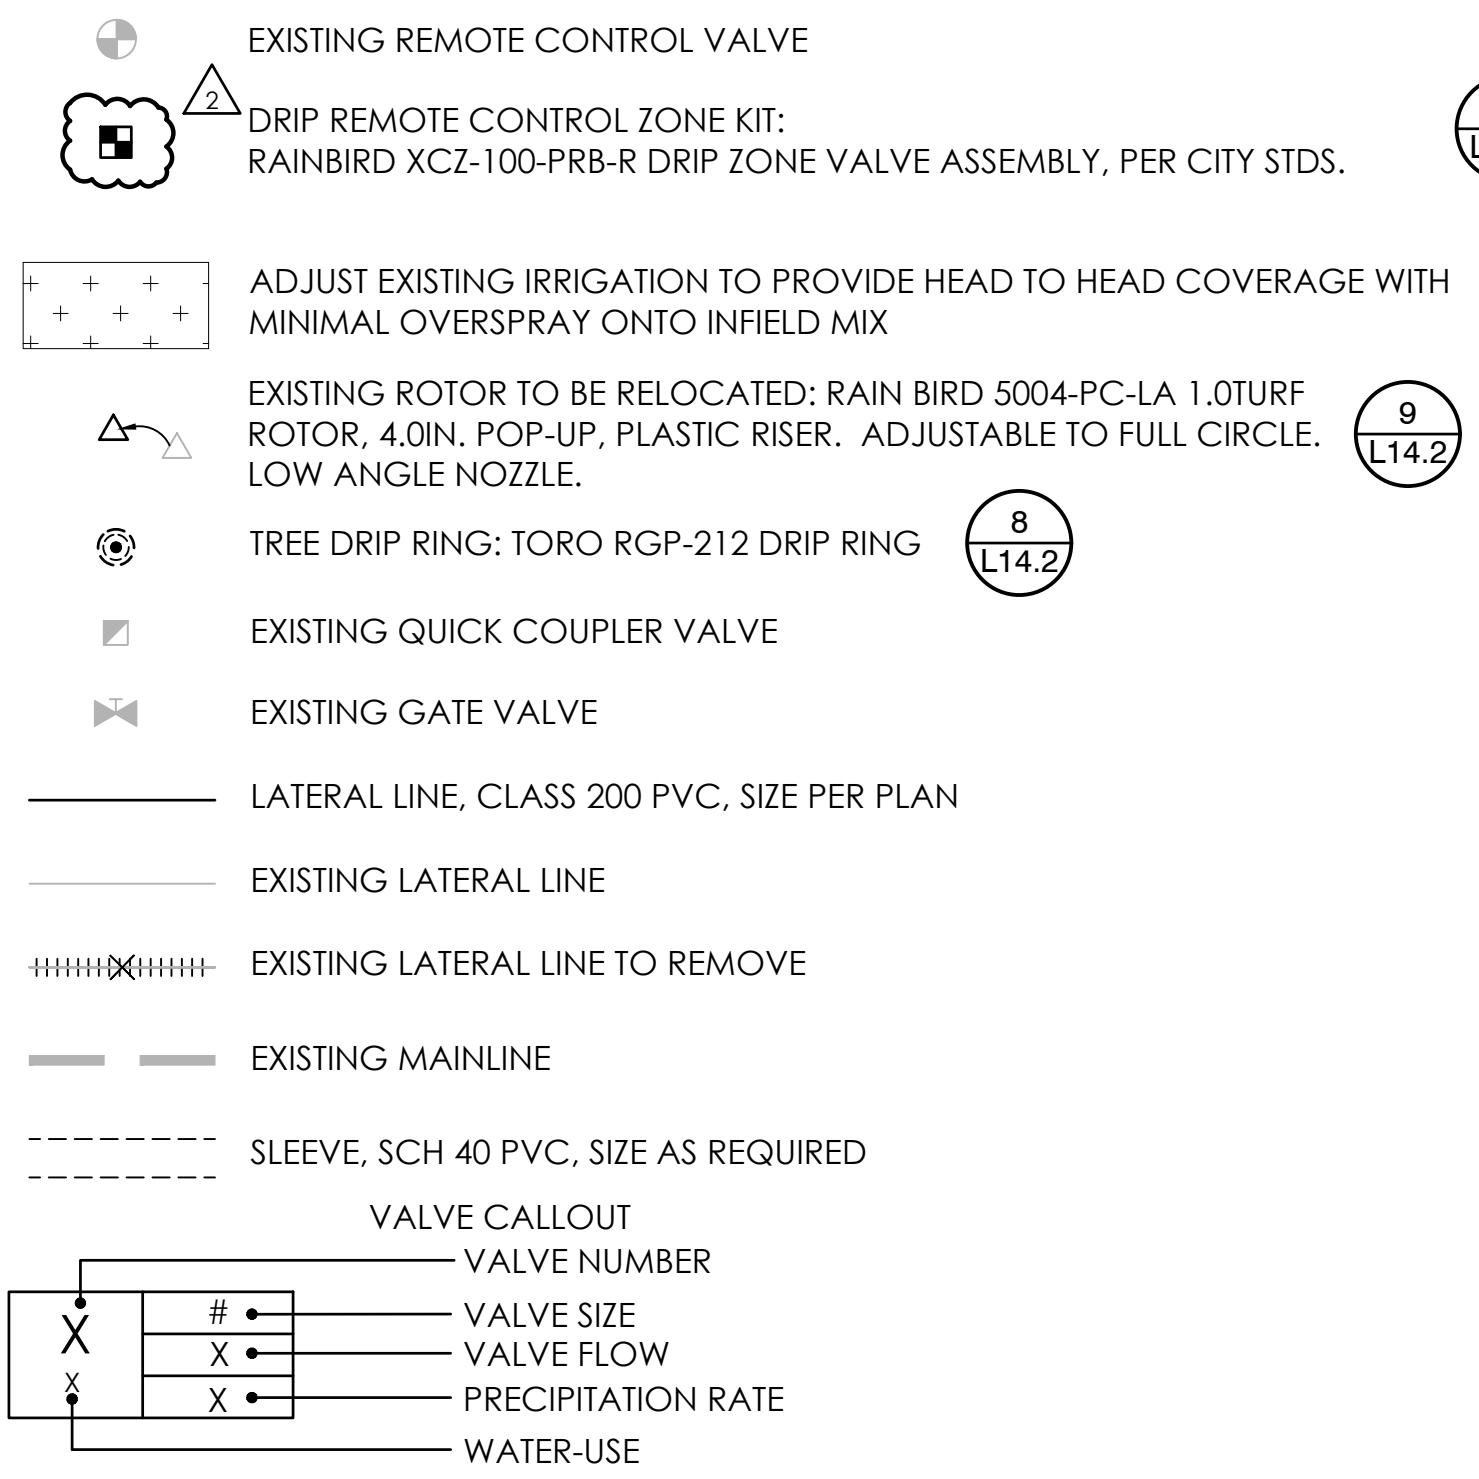


REPAIR TURF AND IRRIGATION COMPONENTS
DAMAGED DURING CONSTRUCTION OPERATIONS"

IRRIGATION NOTES

1. SPECIFICATIONS: SEE IRRIGATION SPECIFICATIONS FOR ADDITIONAL INFORMATION.
2. VERIFICATION: SYSTEM DESIGN IS BASED ON MINIMUM OPERATING PRESSURE OF 50 P.S.I. AND MAXIMUM FLOW DEMAND OF 150 G.P.M. (WITH PUMP) AVAILABLE AT DISCHARGE OUTLET OF METER OR OTHER POINT OF CONNECTION. CONTRACTOR SHALL VERIFY SAME AND NOTIFY LANDSCAPE ARCHITECT IF SUCH DATA ADVERSELY AFFECTS THE OPERATION OF THE SYSTEM. SUCH NOTICE SHALL BE MADE IN WRITING AND PRIOR TO COMMENCING ANY IRRIGATION WORK.
3. UTILITIES: CONTRACTOR SHALL VERIFY LOCATION OF ALL ON-SITE UTILITIES. RESTORATION OF DAMAGED UTILITIES SHALL BE MADE AT THE CONTRACTOR'S EXPENSE TO THE SATISFACTION OF THE CITY/OWNER.
4. SCHEMATIC: SYSTEM FEATURES ARE SHOWN SCHEMATICALLY FOR GRAPHIC CLARITY. INSTALL ALL PIPING AND VALVES IN COMMON TRENCHES WHERE FEASIBLE AND INSIDE PLANTING AREAS WHENEVER POSSIBLE. ALL VALVES SHALL BE LOCATED IN GROUNDCOVER OR SHRUB AREAS WHENEVER POSSIBLE.
5. CODES: IRRIGATION SYSTEM SHALL BE INSTALLED IN ACCORDANCE WITH ALL LOCAL CODES AND MANUFACTURER'S SPECIFICATIONS. NOTIFY CITY BY TELEPHONE AND IN WRITING OF ANY CONFLICTS PRIOR TO INSTALLATION.
6. SLEEVING: CONTRACTOR SHALL SIZE ALL SLEEVES TO BE A MINIMUM TWO TIMES THE SIZE OF THE INTERIOR PIPE. SLEEVES SHALL BE INSTALLED AT THE NECESSARY DEPTHS PRIOR TO
7. PAVEMENT CONSTRUCTION: SLEEVING SHALL EXTEND 1'-0" FROM EDGE OF PAVEMENT INTO TURF OR PLANTING AREA, AND SHALL HAVE ENDS CLEARLY MARKED ABOVE GRADE.
8. BACKFLOW DEVICES: LOCATE BACKFLOW DEVICES AS SHOWN ON PLAN. LOCATION SHALL BE APPROVED BY THE CITY'S REPRESENTATIVE PRIOR TO INSTALLATION BY THE CONTRACTOR.
9. QUICK COUPLING VALVES: INSTALL ON TRIPLE SWING JOINT. LOCATE 12" AWAY FROM EDGE OF WALKS, WALLS, CURBS, AND HEADERBOARDS WITHIN PLANTING AREAS. PROVIDE CITY/OWNER WITH ONE OPERATING KEY, TWO SETS OF LOCKING COVER KEYS, AND ONE SWIVEL HOSE ELL.
10. HEAD ALLOWANCE: CONTRACTOR SHALL ALLOW IN BID PRICE AN AMOUNT SUFFICIENT TO PROVIDE AND INSTALL AN ADDITIONAL 200 FT OF DRIPLINE TO ACCOMMODATE FIELD CHANGES. THESE SHALL BE LOCATED AS DIRECTED BY THE LANDSCAPE ARCHITECT. CONTRACTOR SHALL DELIVER TO THE CITY ANY UN-USED DRIPLINE AT THE END OF THE MAINTENANCE PERIOD.
11. Maintaining Existing Irrigation: Should the existing mainline break or be shut off for any reason during the course of construction, the contractor shall hand water all planting material, including, but not limited to, trees, shrubs, turf, and groundcover that the existing irrigation system waters. The contractor shall continue to do so until the irrigation system is operable.

KEY MAP

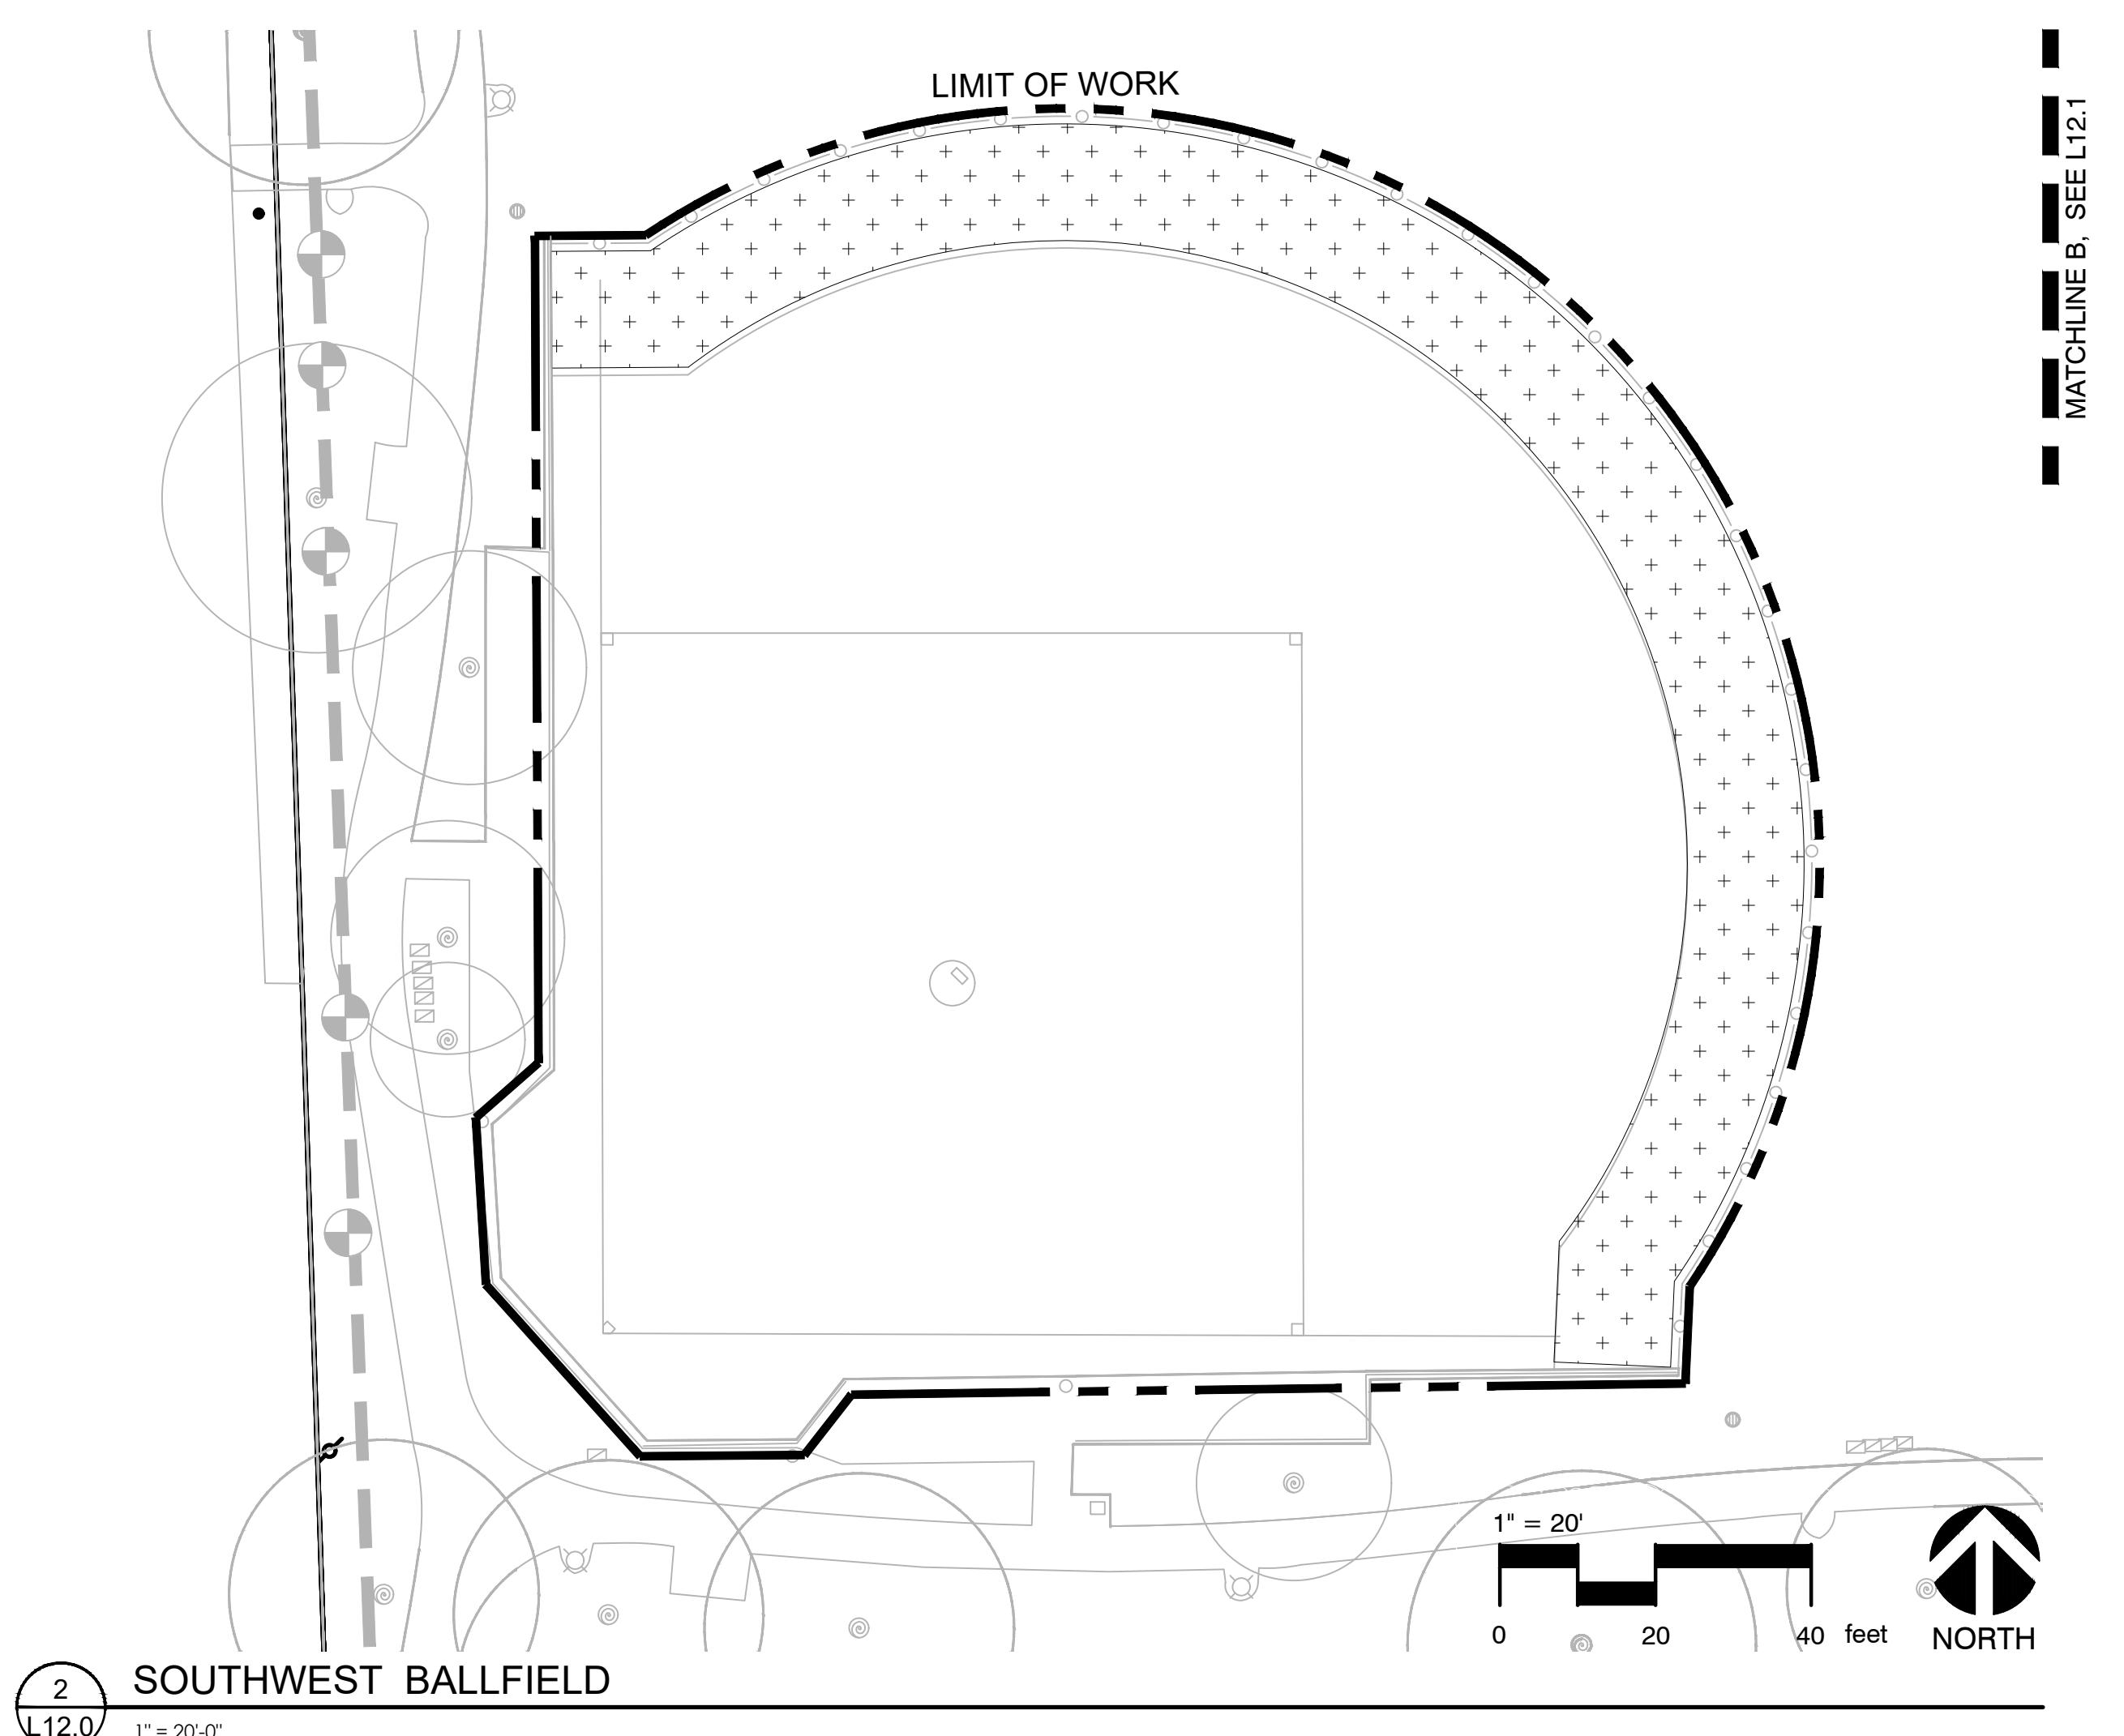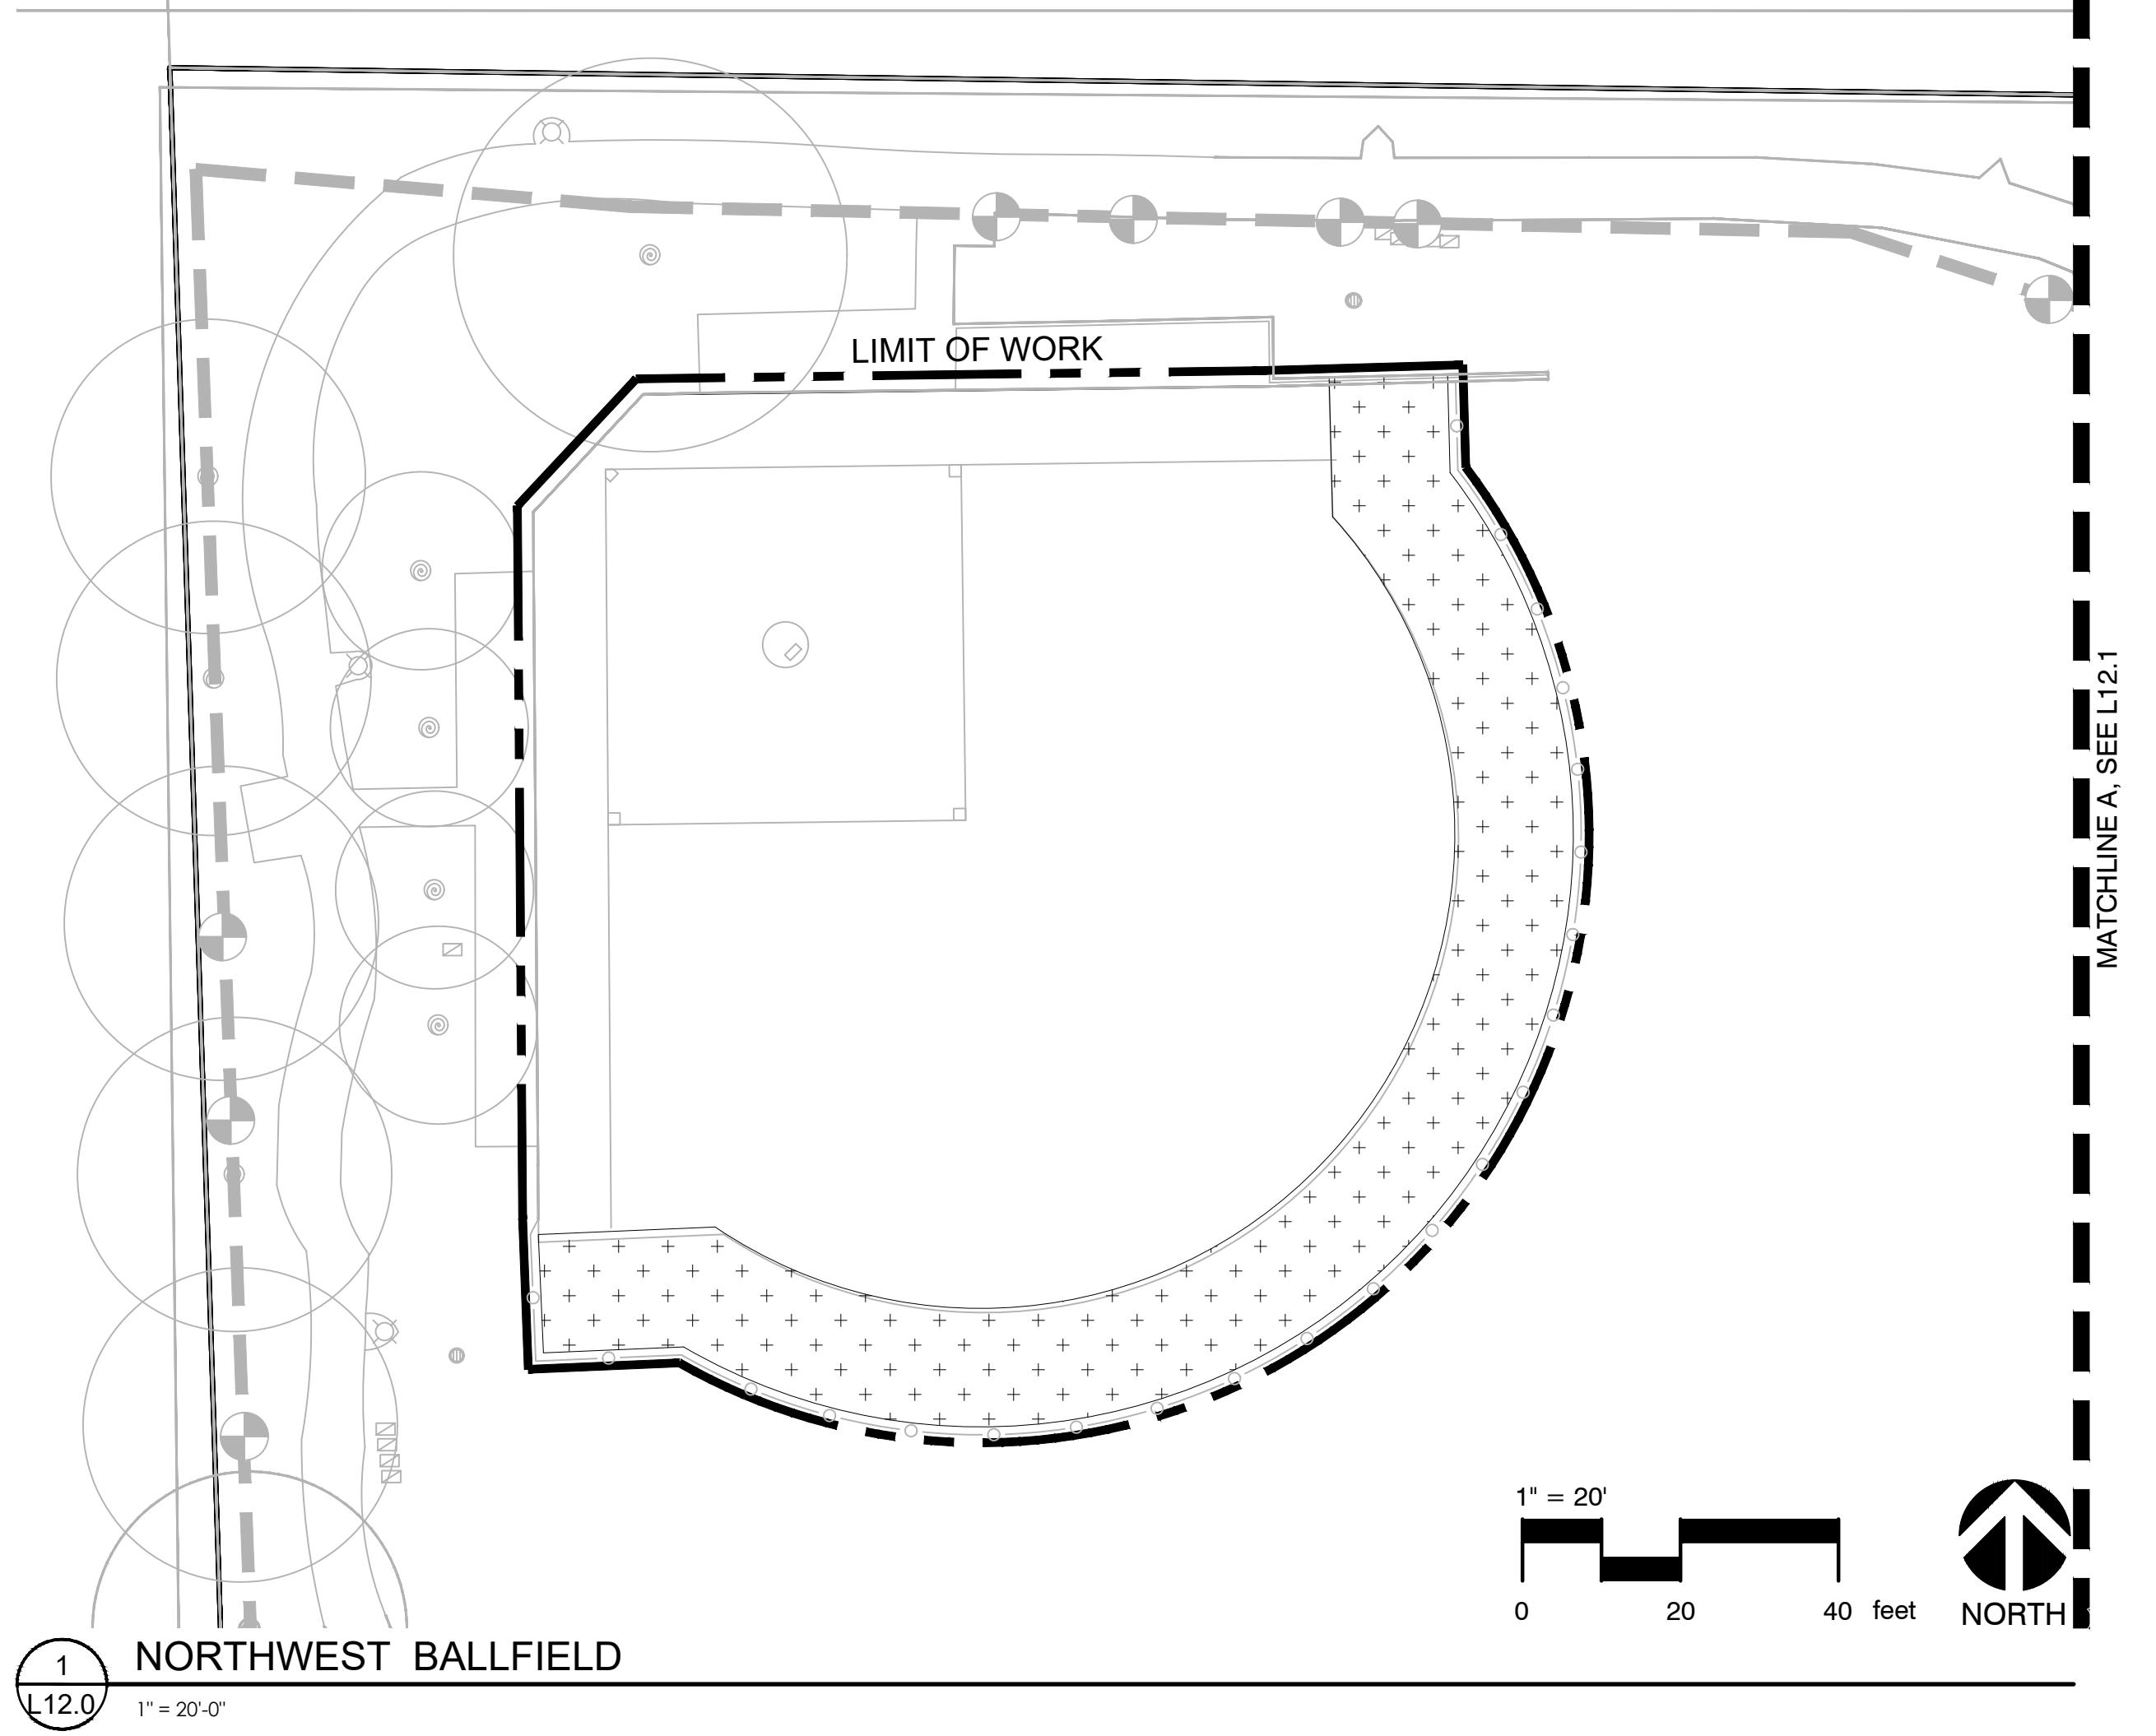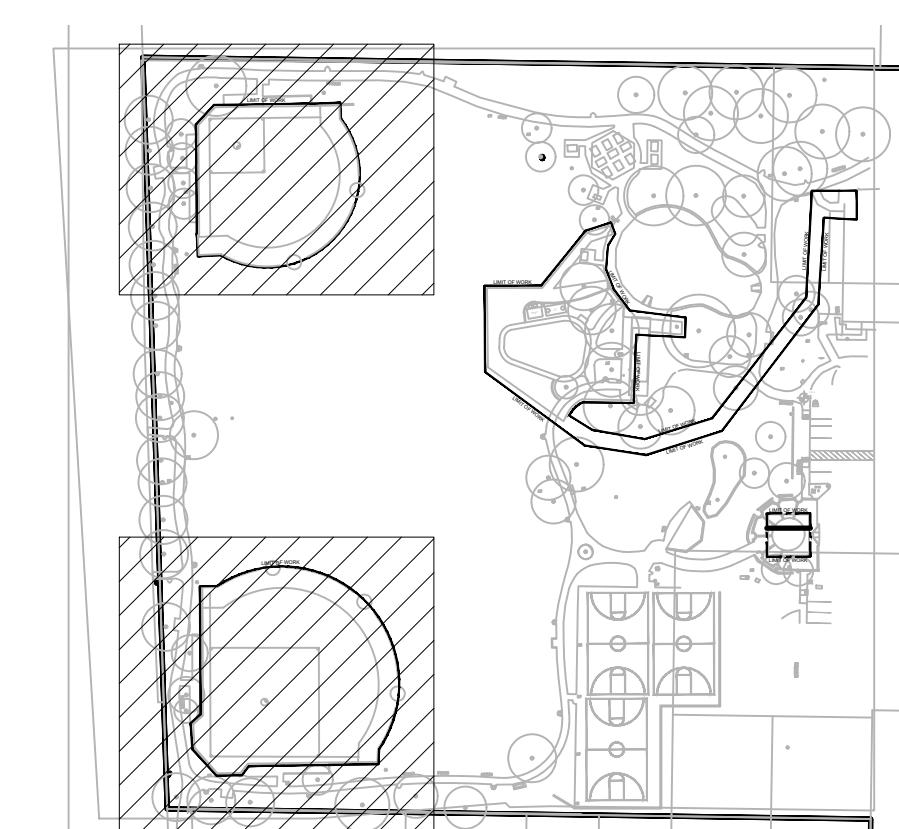



12150 Tributary Point Drive, Suite 140
Gold River, CA 95670
1 916.985.4366
www.calanderassociates.com

REVISION DATE
ADDENDUM 2 01/09/2026



MOSSDALE LANDING AND VALVERDE PARK RENOVATION

LATHROP, CA

SUBMITTAL DATE
50% CDs 05/03/25
100% CDs 08/27/25
BID SET 11/14/25


PROJECT NO: 25003
DRAWN BY: RH
CHECKED BY: MR
SCALE: As Shown

DETAILS

SHEET


L14.2

28 OF 37

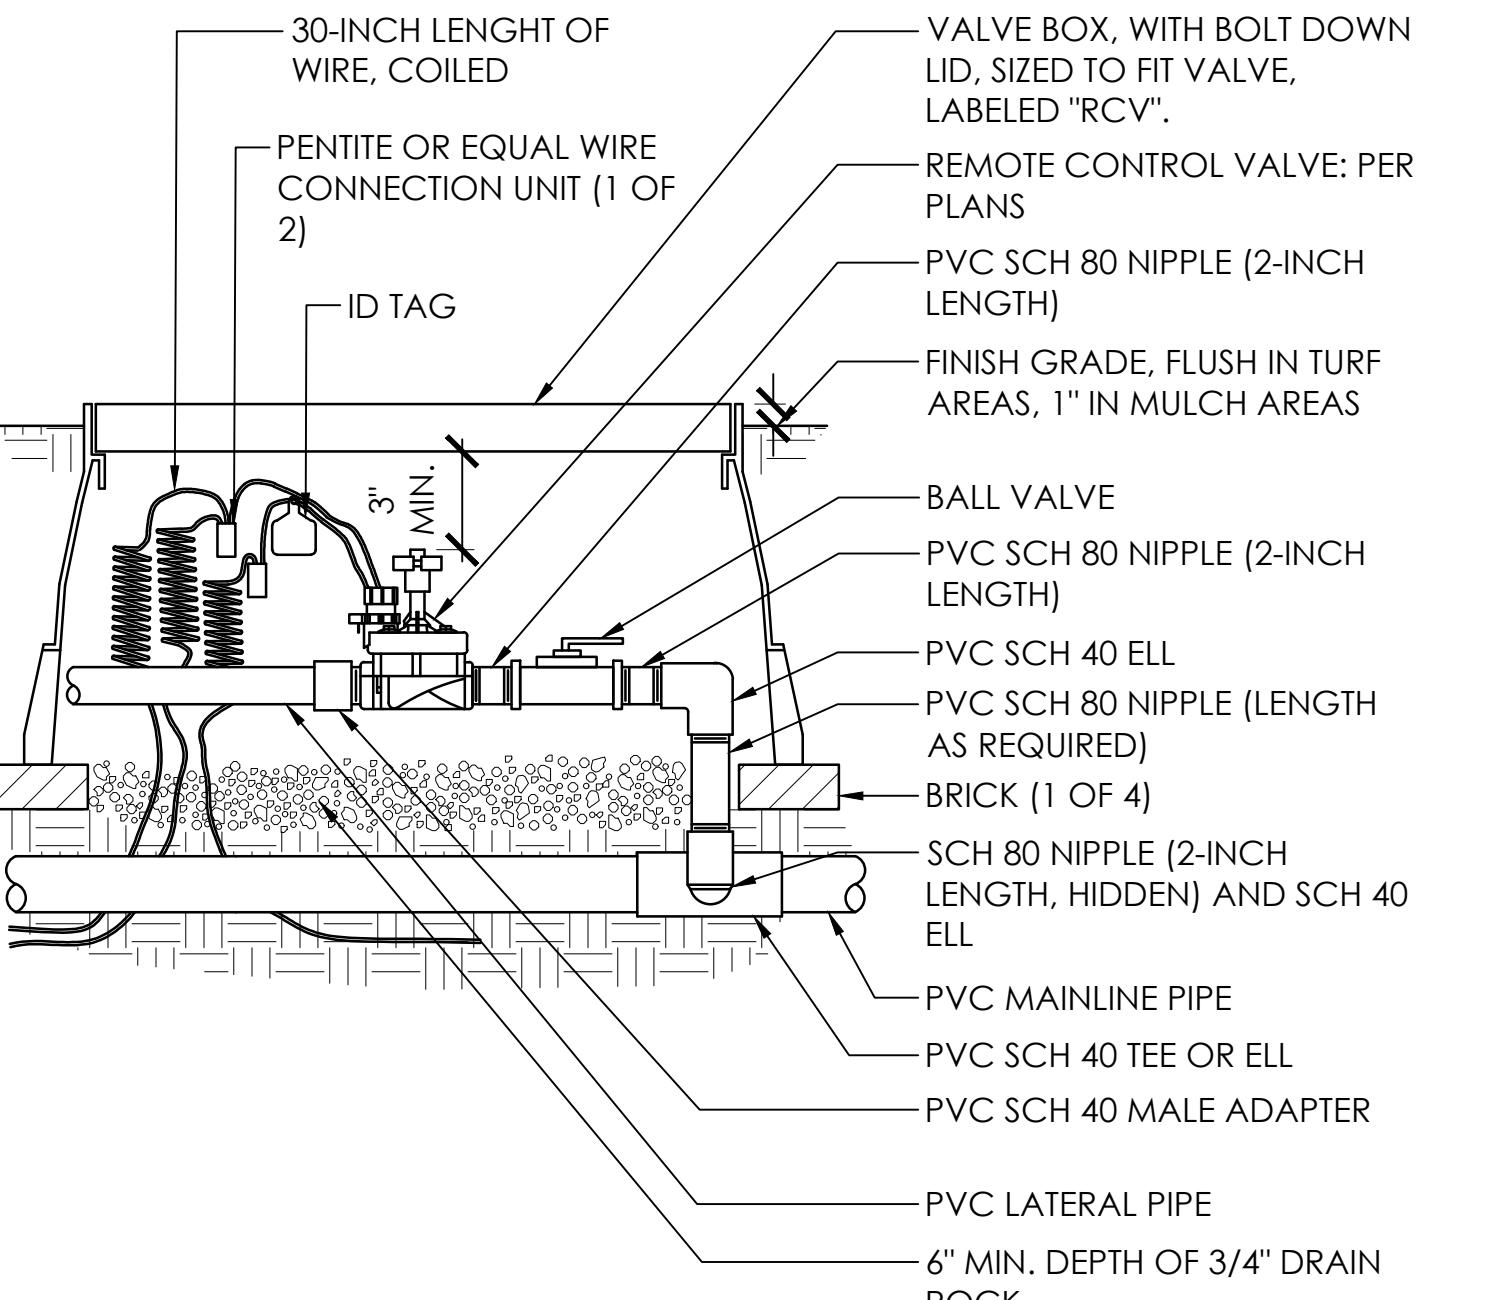


1 REMOTE CONTROL VALVE

L14.2 1" = 1'-0"

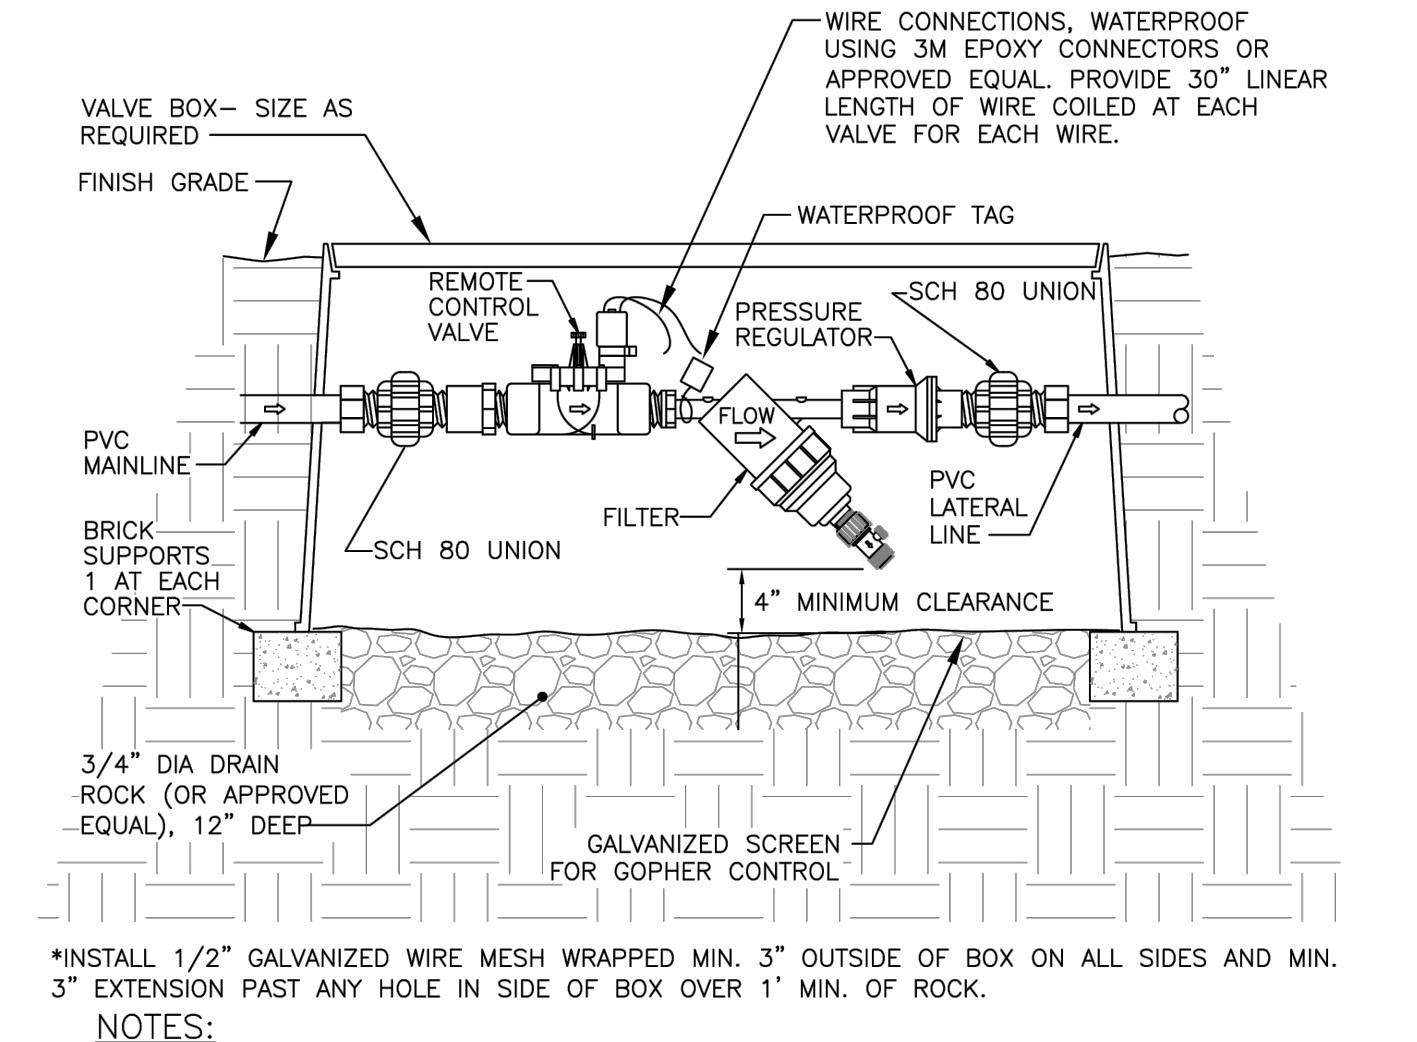


2 Drip Irrigation Control Valve Assembly - City Standard

L14.2 N.T.S. P-25-003-32

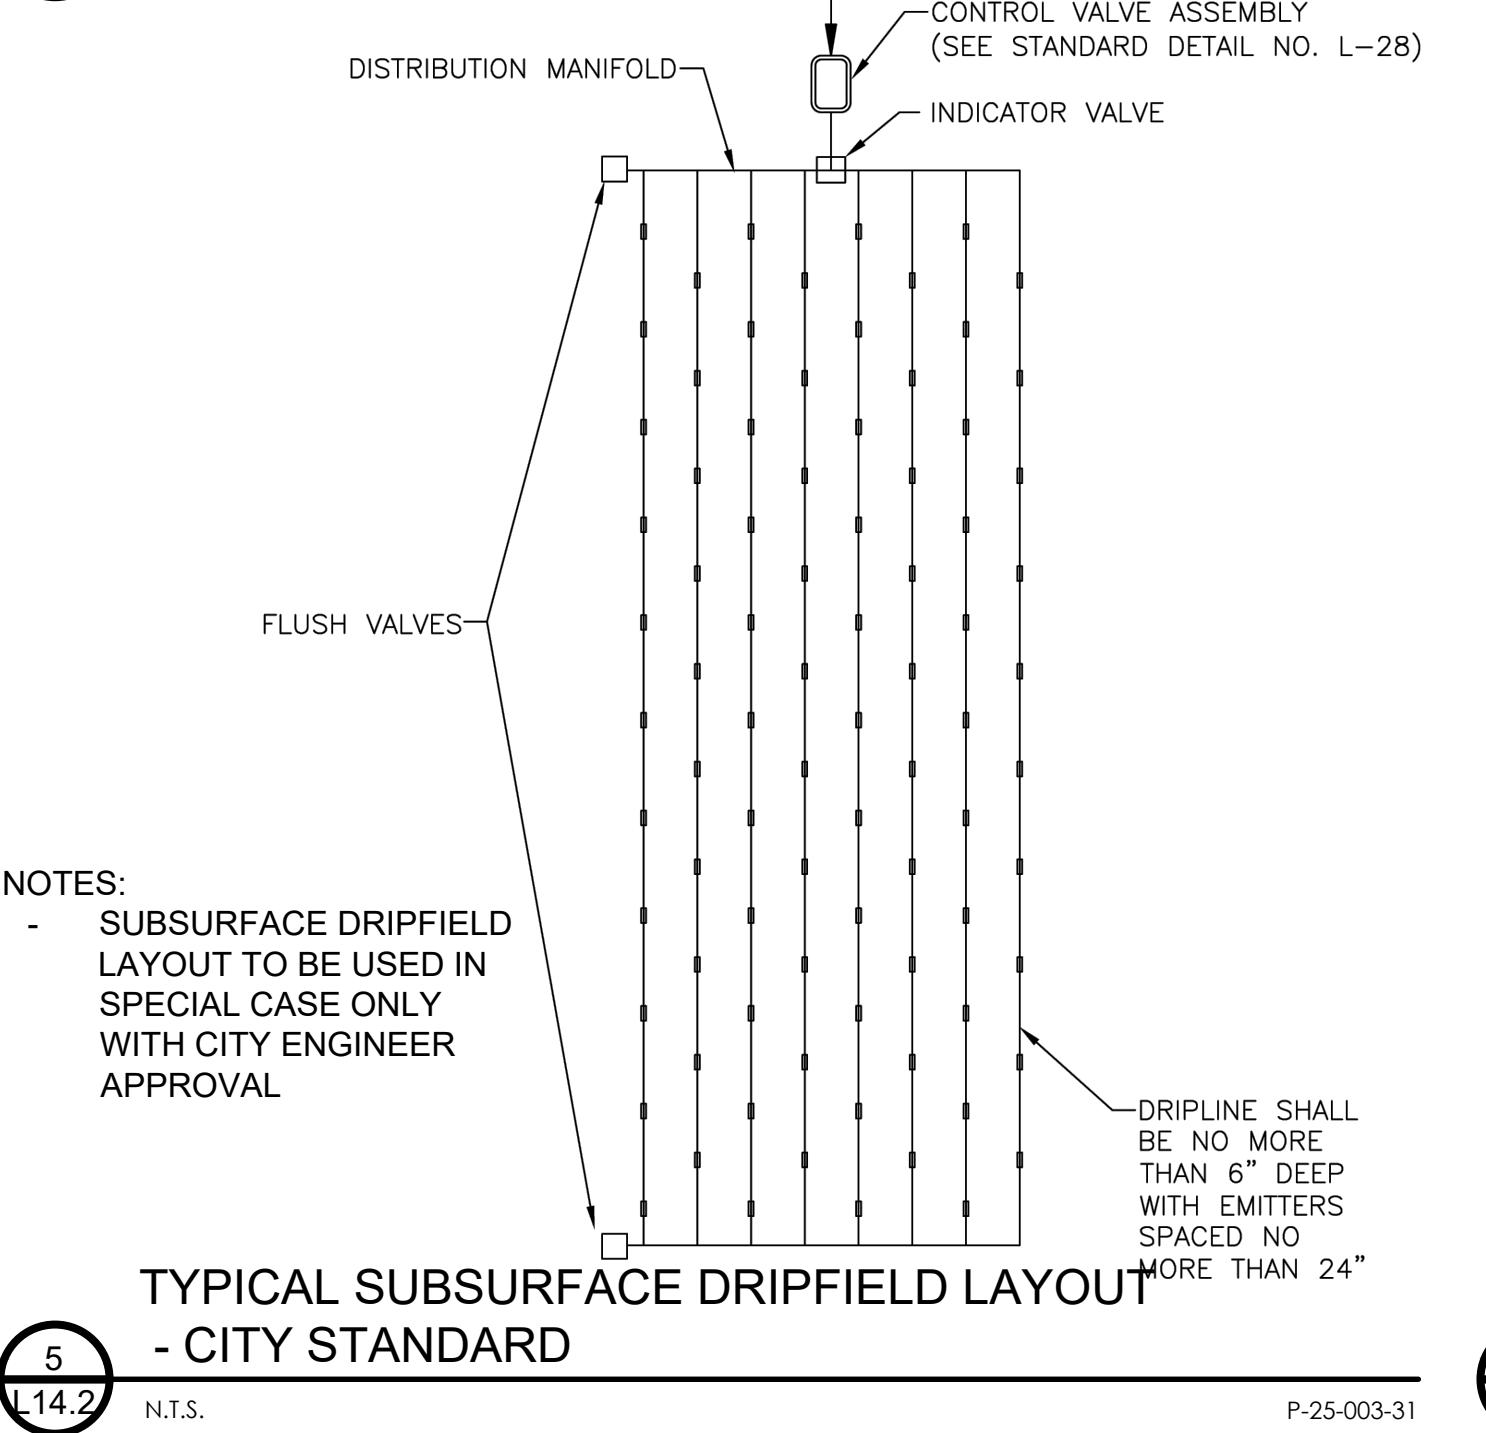


5 TYPICAL SUBSURFACE DRIPFIELD LAYOUT - CITY STANDARD

L14.2 N.T.S. P-25-003-31

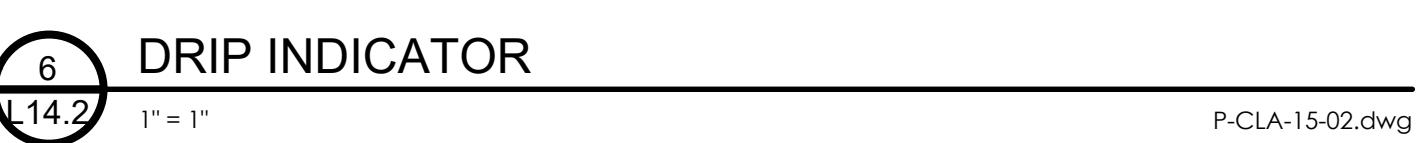


6 DRIP INDICATOR

L14.2 1" = 1" P-25-003-31

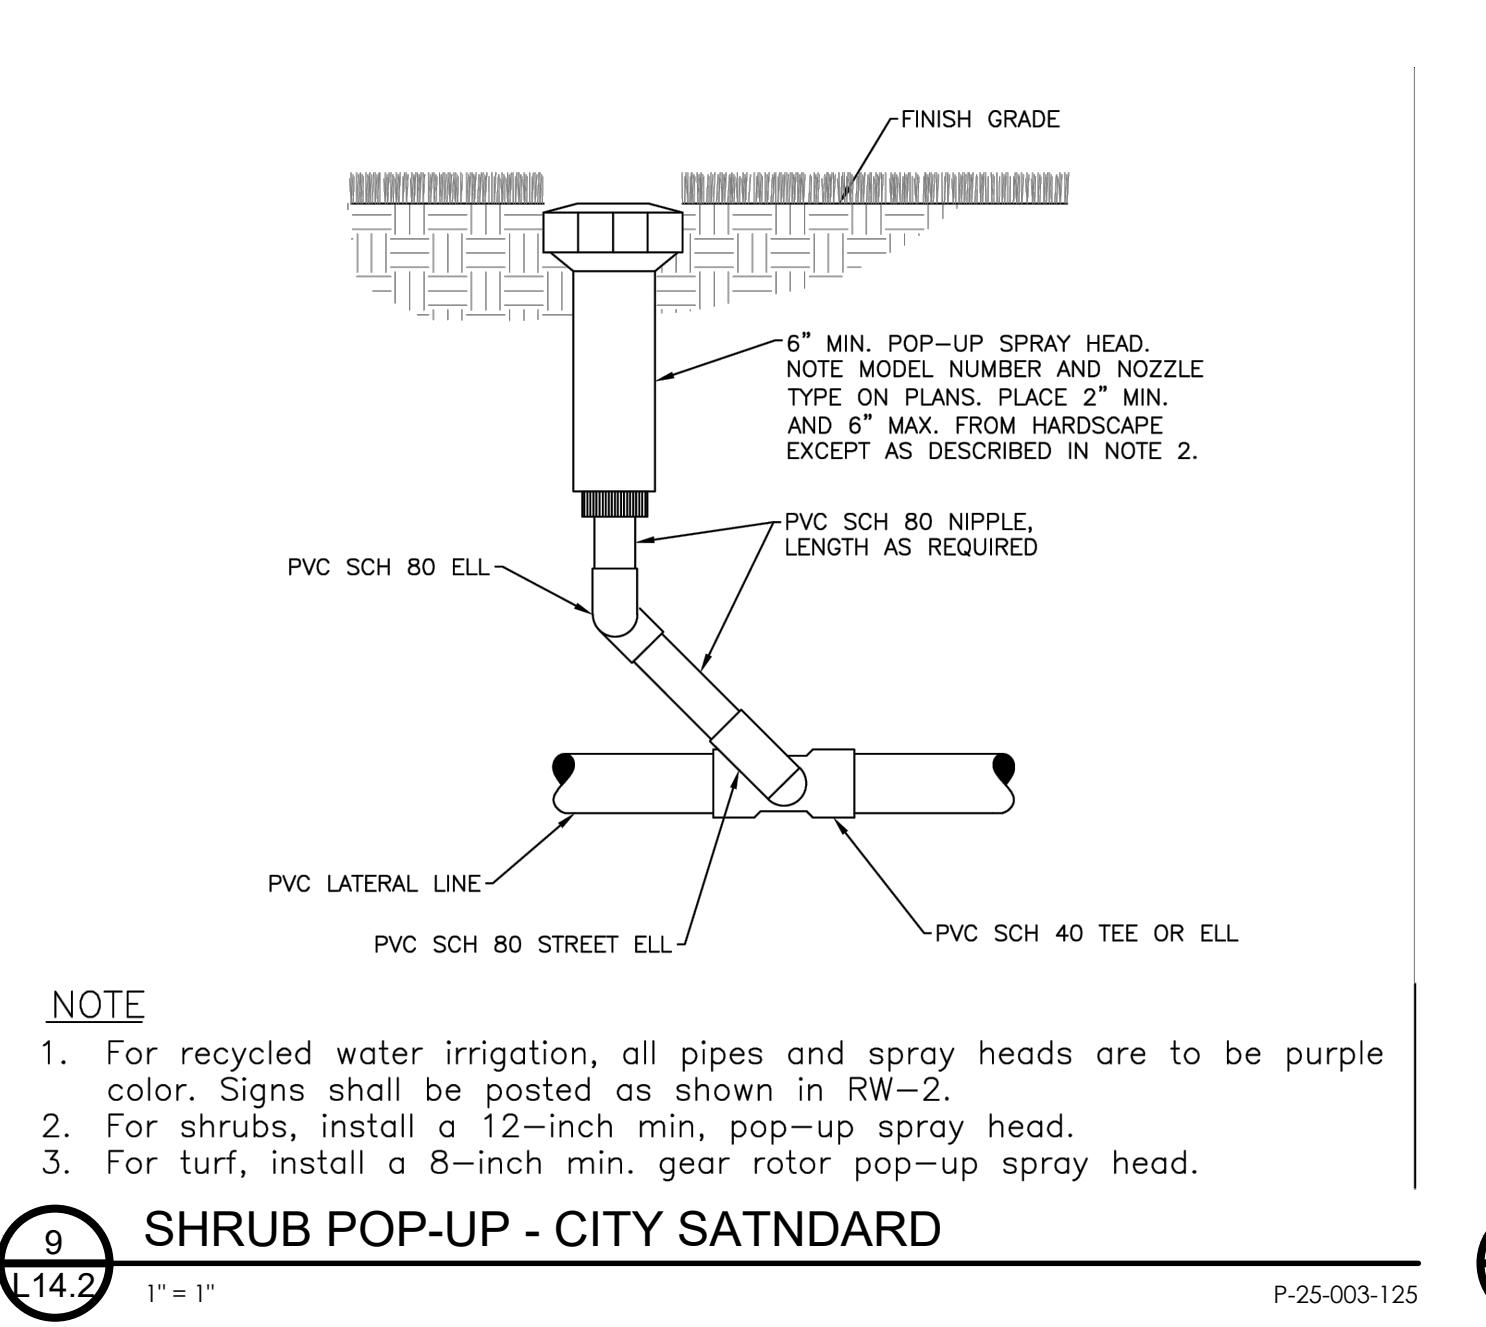


9 SHRUB POP-UP - CITY STANDARD

L14.2 1" = 1" P-25-003-125

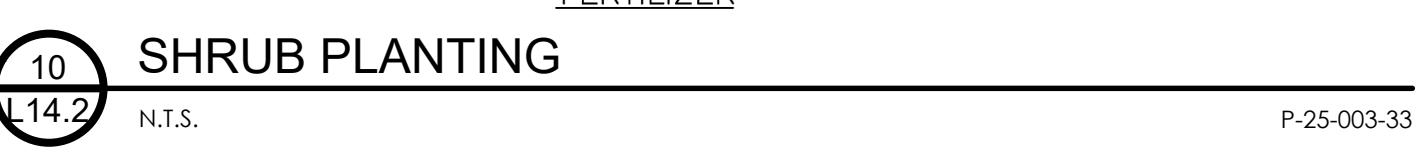

10 SHRUB PLANTING

L14.2 N.T.S. P-25-003-125

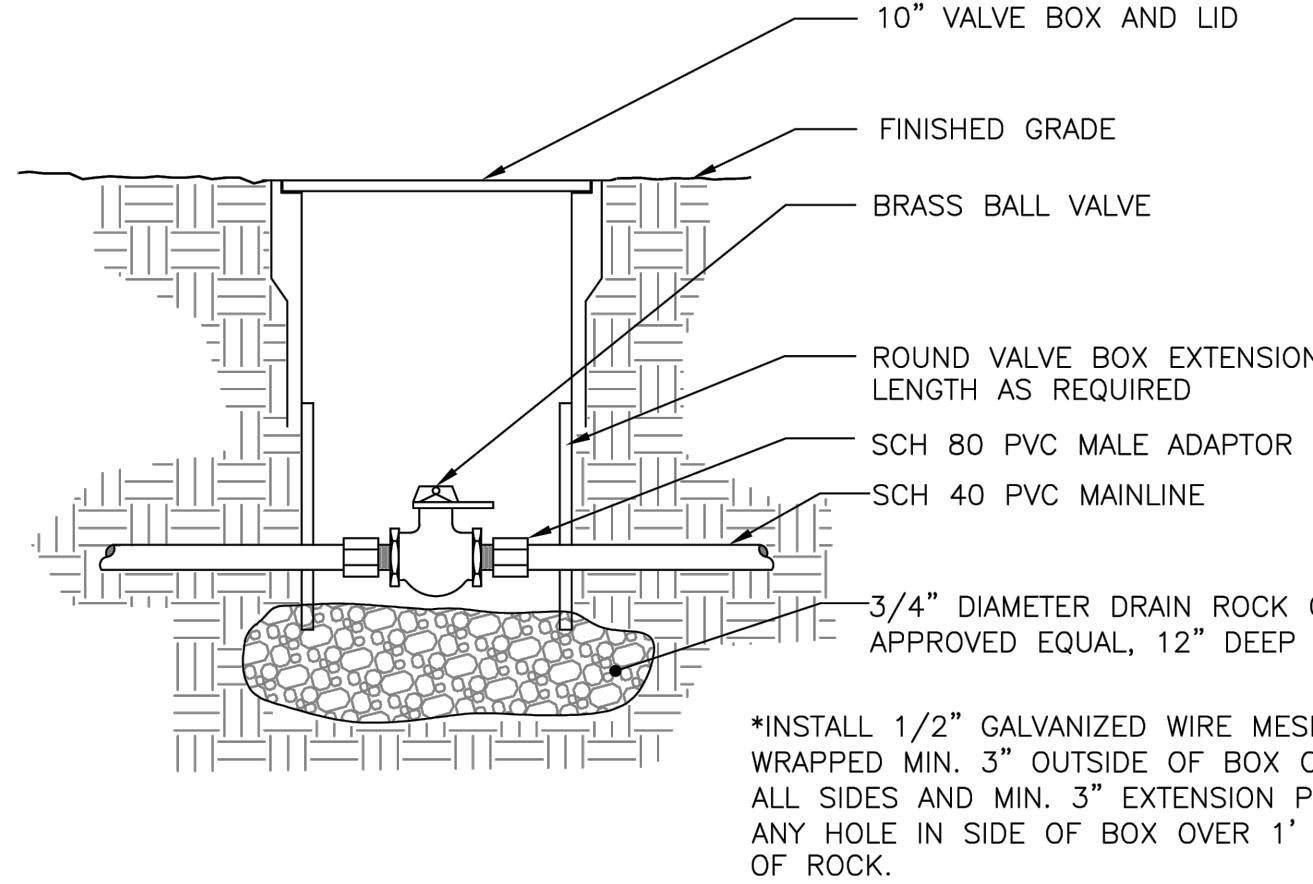


NOTES:

1. See L-6 for control valve installation notes.
2. For irrigation, all pipes, tags, valve boxes and lids are to be purple color with language as shown on RW-2.
3. Brand box lid with appropriate designation. Branding shall correspond with tag. All boxes shall be bolt down.


3 GATE VALVE - CITY STANDARD

L14.2 N.T.S. P-25-003-93

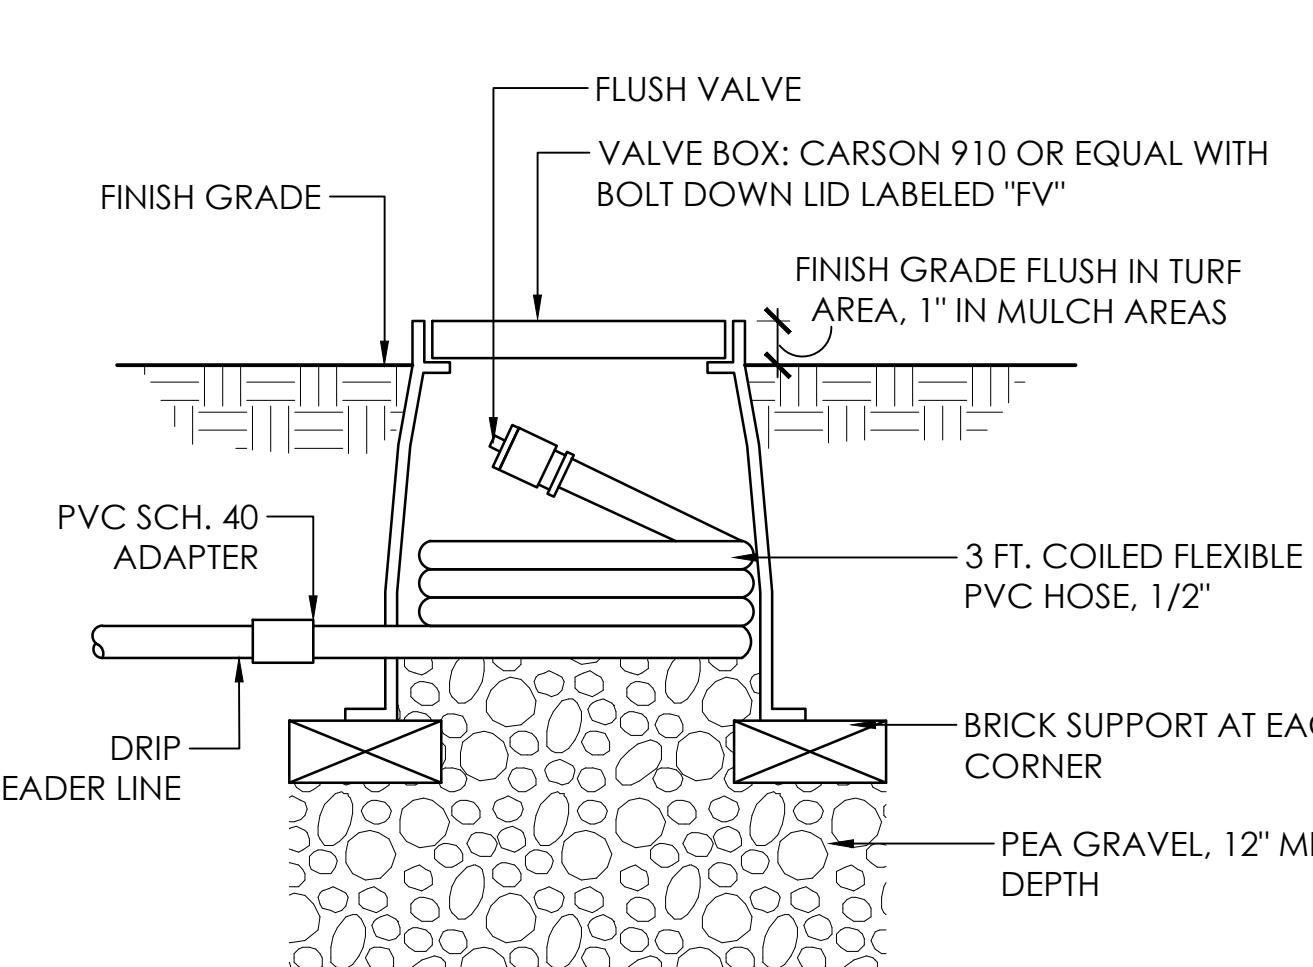

7 DRIP FLUSH VALVE

L14.2 1 1/2" = 1'-0" P-CLA-15-18.dwg

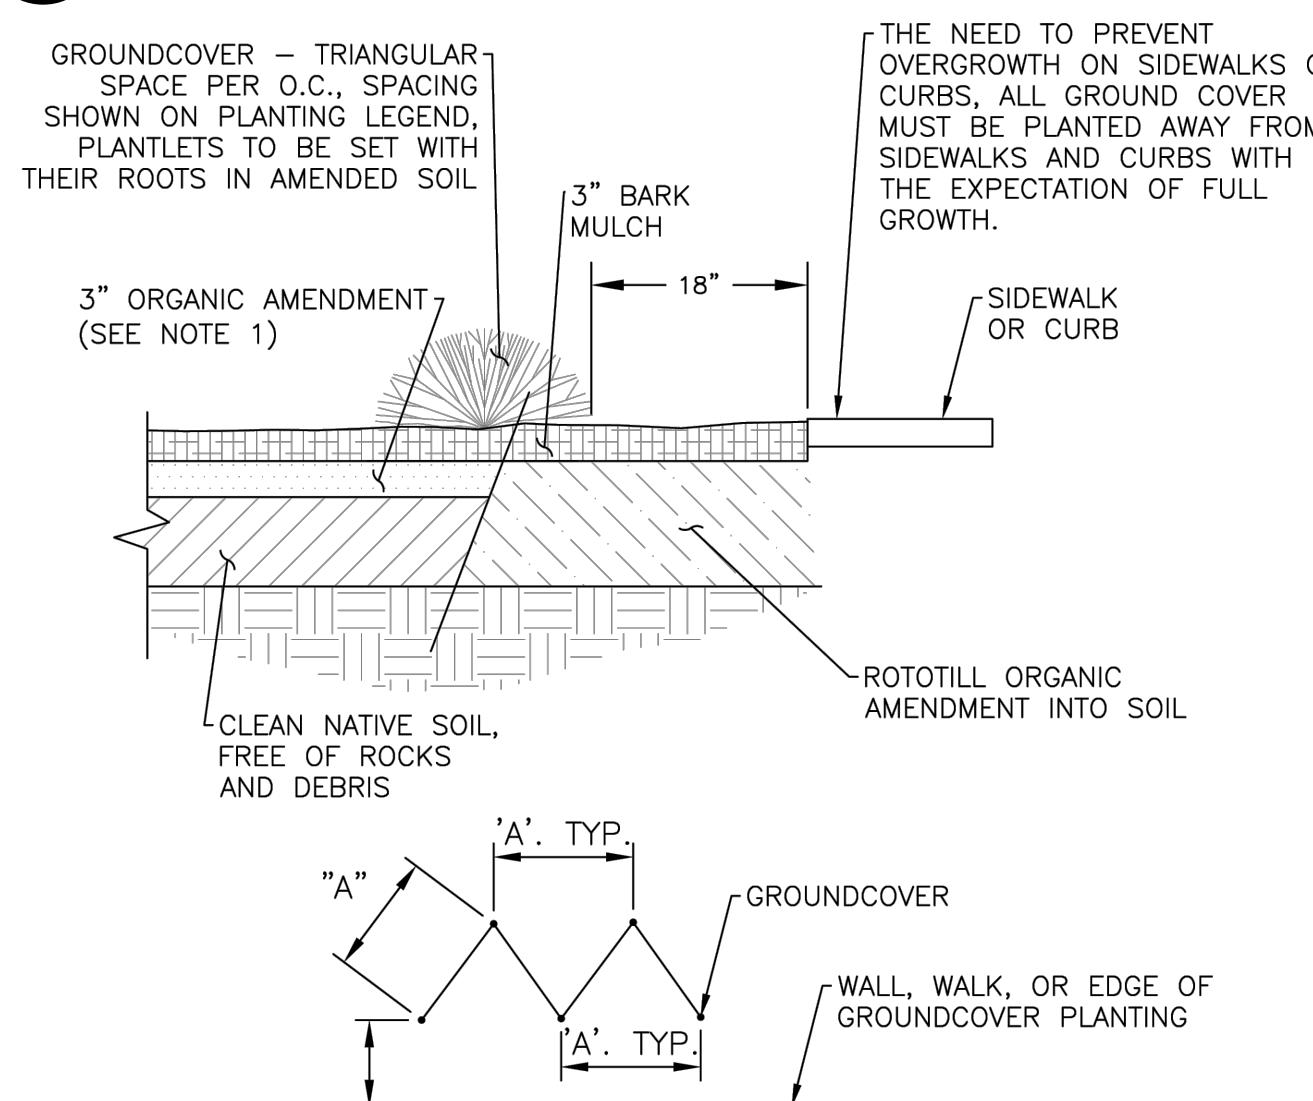

11 GROUNDCOVER PLANTING AND SPACING - CITY STANDARD

L14.2 N.T.S. P-25-003-36



10± DIA. Q.C. ROUND PLASTIC VALVE BOX LID

FINISHED GRADE

BRASS BALL VALVE

ROUND VALVE BOX EXTENSION, LENGTH AS REQUIRED

SCH 80 PVC MALE ADAPTOR

SCH 40 PVC MAINLINE

3/4" DIAMETER DRAIN ROCK OR APPROVED EQUAL, 12" DEEP

*INSTALL 1/2" GALVANIZED WIRE MESH WRAPPED MIN. 3" OUTSIDE OF BOX ON ALL SIDES AND MIN. 3" EXTENSION PAST ANY HOLE IN SIDE OF BOX OVER 1' MIN. OF ROCK.

NOTES:

1. All Nipples and Joints to be Schedule 80 PVC.
2. For recycled water irrigation, only quick couplers that differ from potable water quick couplers shall be allowed.
3. For irrigation, all pipes, tags and valve boxes are to be purple color with language shown on Standard Detail No. RW-2.
4. Brand box lid with appropriate designation. Branding shall correspond with tag.

4 QUICK COUPLER - CITY STANDARD

L14.2 N.T.S. P-25-003-97

EXISTING TREE SIZE PER PLAN


FIRST RING SPACING (X)

DRIP RING SPACING AND EXTENT (Y)

A (LG. TREE) 3 FT FROM TRUNK EVERY 3 FT O.C. TO EXTENT OF TREE CANOPY. 2 RINGS MIN/ 4 RINGS MAX.


7 DRIP FLUSH VALVE

L14.2 1" = 1" P-CLA-15-18.dwg

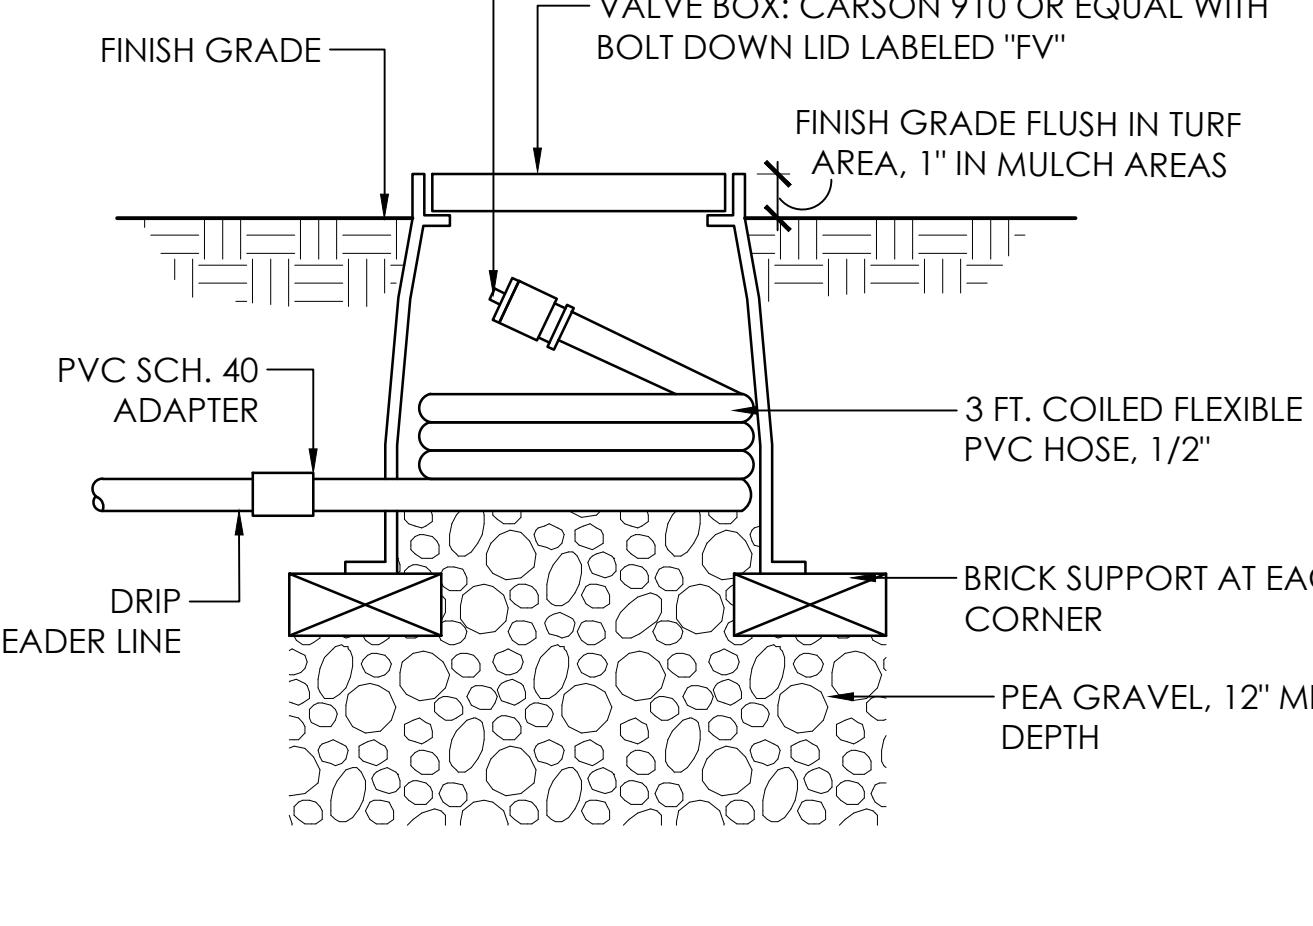

8 TREE DRIP RING LAYOUT

L14.2 1" = 1" P-CLA-15-18.dwg

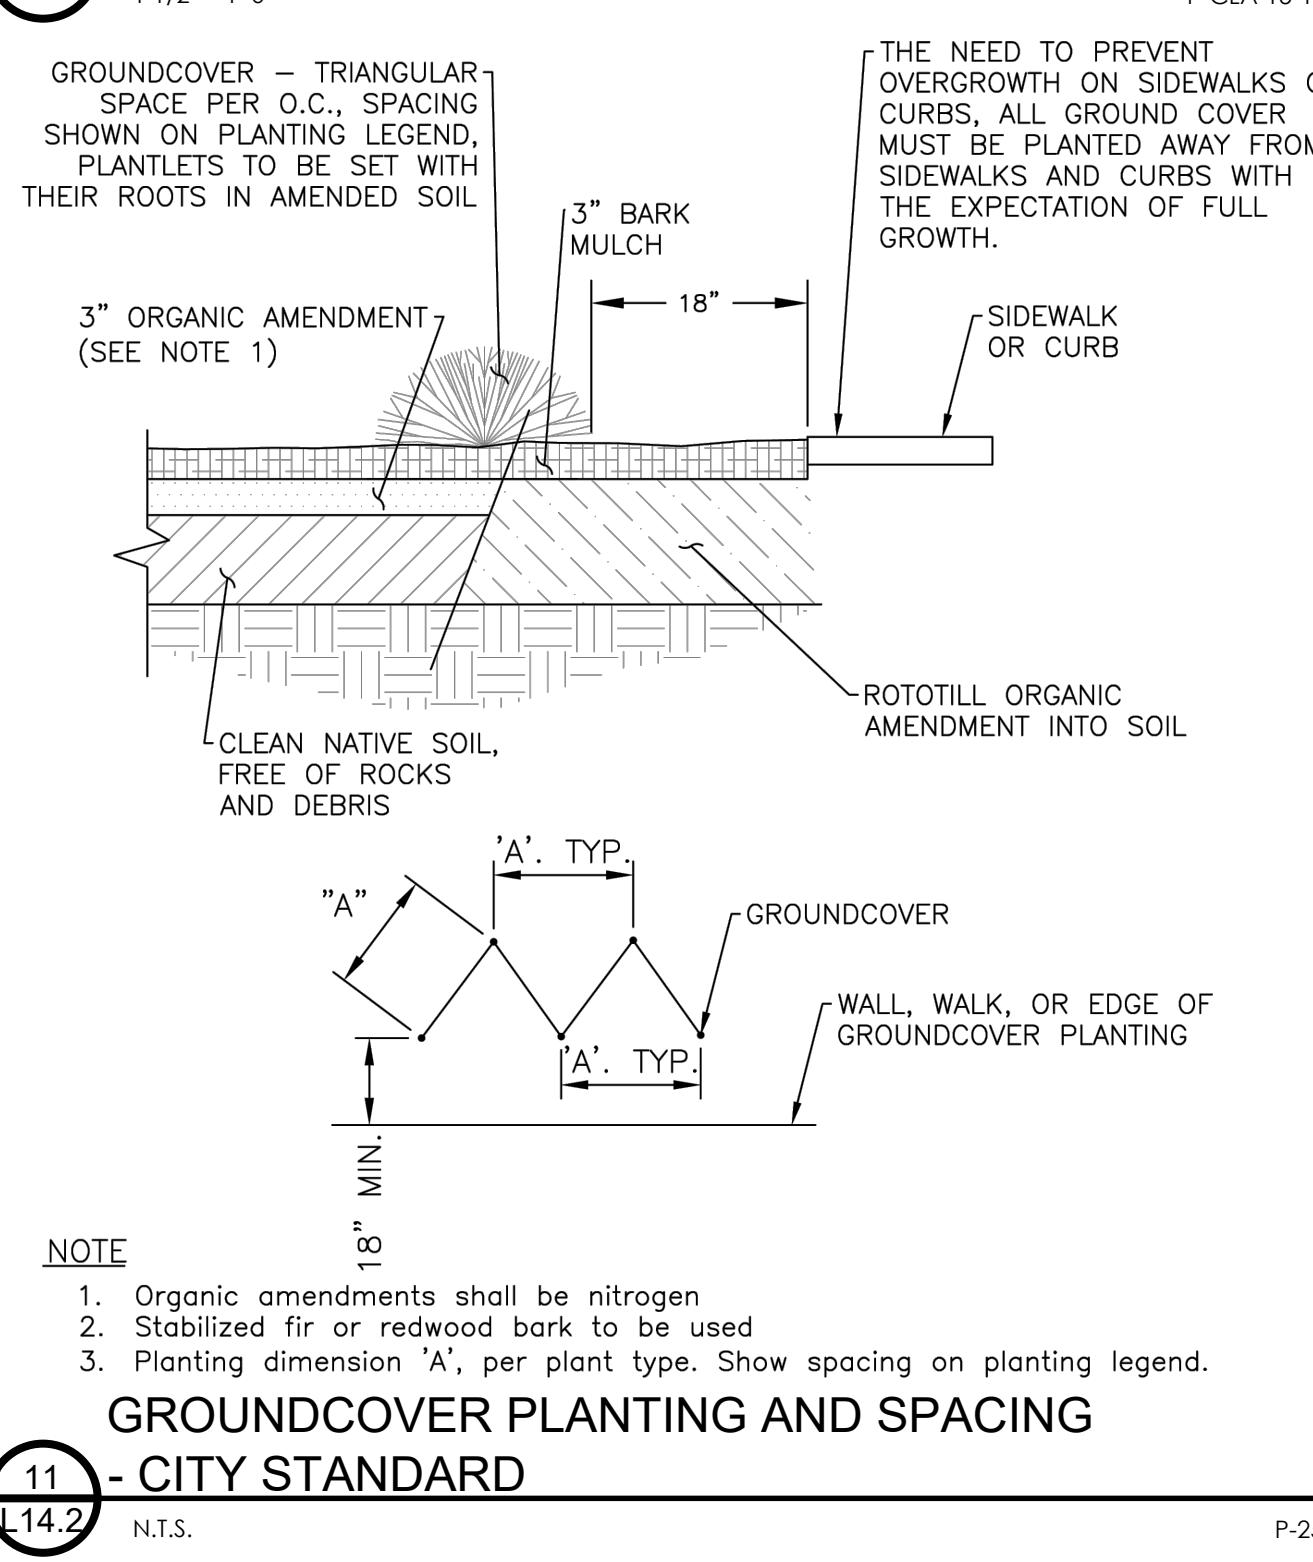

10± DIA. Q.C. ROUND PLASTIC VALVE BOX LID

FINISHED GRADE

BRASS BALL VALVE

ROUND VALVE BOX EXTENSION, LENGTH AS REQUIRED

SCH 80 PVC MALE ADAPTOR

SCH 40 PVC MAINLINE

3/4" DIAMETER DRAIN ROCK OR APPROVED EQUAL, 12" DEEP

*INSTALL 1/2" GALVANIZED WIRE MESH WRAPPED MIN. 3" OUTSIDE OF BOX ON ALL SIDES AND MIN. 3" EXTENSION PAST ANY HOLE IN SIDE OF BOX OVER 1' MIN. OF ROCK.

NOTES:

1. All Nipples and Joints to be Schedule 80 PVC.
2. For recycled water irrigation, only quick couplers that differ from potable water quick couplers shall be allowed.
3. For irrigation, all pipes, tags and valve boxes are to be purple color with language shown on Standard Detail No. RW-2.
4. Brand box lid with appropriate designation. Branding shall correspond with tag.

10± DIA. Q.C. ROUND PLASTIC VALVE BOX LID

FINISHED GRADE

BRASS BALL VALVE

ROUND VALVE BOX EXTENSION, LENGTH AS REQUIRED

SCH 80 PVC MALE ADAPTOR

SCH 40 PVC MAINLINE